


Section 5 Township 10 Range 18 W

Well No. #2
~~#7 Williams~~

Company K + E Drilg.
~~Barnett Oil~~

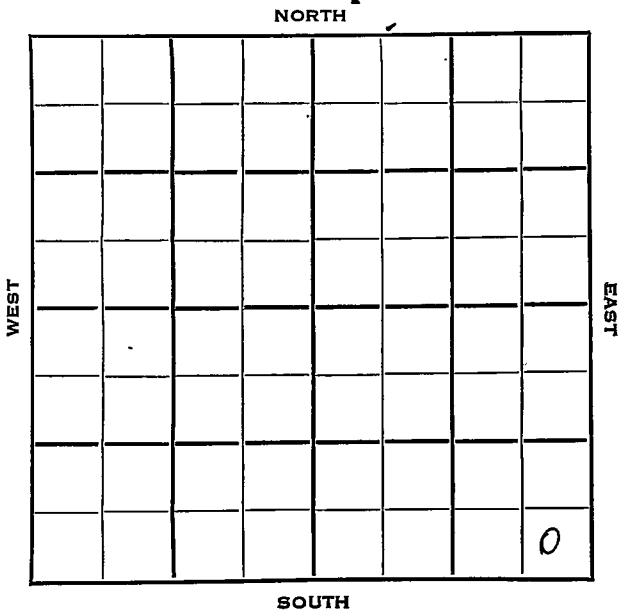

16

WEST

EAST

1955
2/16

O.W.W.O.

Lans. 3405' Cong 3644' Simp. dol. 3710'
Arb. 3747' OTD 3767' CO to 3767'
5" @ 3767'

4/27

Oil Well
TD 3771'
Lans. 3405', Cong. 3644' Simp dol.
3710' Arb. 3747'
OTD 3767'
CO to 3767'
DD 3771'
5" @ 3770'
CO to 3746'
16/ 3726'-30' 500 A S/ 4 boph 4
hr.
Comp 32 bopd.

COMPLETED


County Rooks State Kansas

Sec. 5 (Blk. Twp.) 10 (Sur. Rge.) 18W Map No.

Operator Barnett Oil

Well No. 1 Farm Williams

Elev. 2185 Location SE SE SE

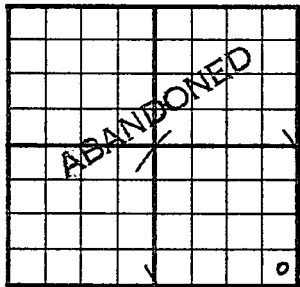

330 Ft. From S Line SE

330 Ft. From E Line Quarter

1st. Report

Completion APR 7 1954

Remarks

Barnett - Contr.

Spudding Date 3-19-54

Drlg. Data D & A TD 3767

8" @ 162 Anhy 1590 Top. 3147

DST 3308-36 open 1 hr. Rec. 225' sw

1045# Heeb. 3364 DST 3383-3412

open 1 hr. Rec. 35' socm 915#

Tor. 3381 Lans. 3405 DST 3466-76

open 1 hr. Rec. 15' socm 20#

DST 3486-3507 open 1 hr. Rec. 15' mud

360# Cong. 3644 Arb. 3747 TD 3767

D & A

