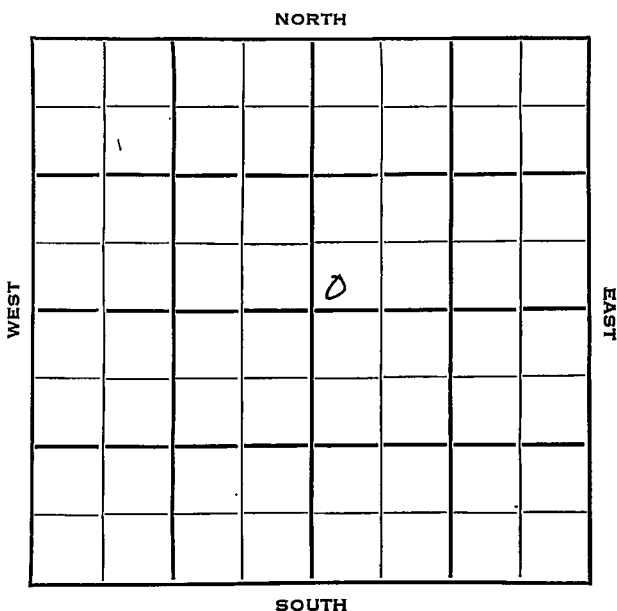


Section 5 Township 10 Range 18WWell No. #1 Hilgers "A"Company G - M - R Oil Company

Rooks **KANSAS** ✓Sec. 5 Twp. 10 R. 18WWell No. #1 Hilgers "A" FarmG&M-R Oil

Company

Wildcat

Contractor

Ft. from N. Line

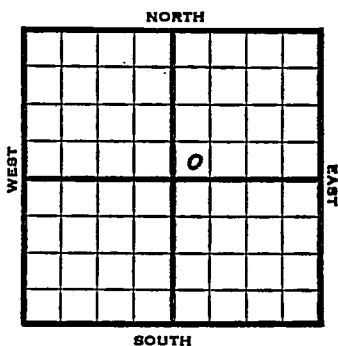
330

Ft. from S. Line

Ft. from E. Line

330

Ft. from W. Line

SW SW NE
Mid-States DHM

1953. Elev. 2185' REPORT

3/25

Spud 3-20-53
8" @ 180Spud 3-20-53
Anhy 1581-1617
Drlg. 2744'

4/1

Spud 3-20-53

D & A

TD 3801

8" @ 180

Anhy 1581, Top 3154, Heeb 3367,
Tor 3387, Lans 3408,DST 3445-95 open 1 hr. Rec 60' wcm
1060#

Cong 3659

DST 3661-75 open 1 hr Rec 27' Mud 0#

ReSimp 3717, Simp Sh 3737, Arb 3751
TD 3801

D & A

ABANDONED

County Rooks State Kansas

Sec. 5 (Blk. Twp.) 10 (Sur. Rge.) 18W Map No.

Operator G-M-R Oil

Well No. 1 Farm Hilgers "A"

Elev. 2185 Location SW SE NE

0

FIRST REPORT

330 Ft. From S Line ... NE

330 Ft. From V Line Quarter

1st. Report MAR 25 1953

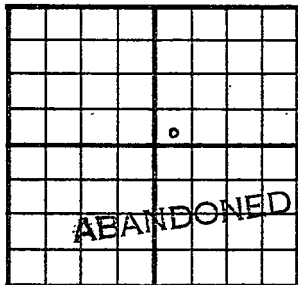
Completion

Remarks Mid-States - DEM

Spudding Date **3-20-53**

Drlg. Data Wildcat

8^u @ 180 Anhy 1581-1617 drlg. 2744

County _____ Rocks _____ State KansasSec. 5 (Blk. Twp.) 10 (Sur. Rge.) 18W Map No. _____Operator. G-M-R OilWell No. 1 Farm Hilgers "A"Elev. 2185 Location SW SW NE330 Ft. From S Line NE330 Ft. From W Line Quarter1st. ReportCompletion APR 1 1953Remarks WildcatSpudding Date 3-20-53Drig. Data D & A TD 38018"@ 180 Anhy 1581 Top. 3154Heeb. 3367 Tor. 3387 Lans. 3408DST 3445-95 open 1 hr. Rec. 60' wcm1060# Cong. 3659 DST 3661-75 open 1 hrRec. 27' mud 0# ReSimp. 3717Simp. sh. 3737 Arb. 3751 TD 3801D & A