


DX 78-1

Rooks KANSAS

Section 5 Township 10 Range 18W

Well No. 1 Williams


Company K & E Drlg.

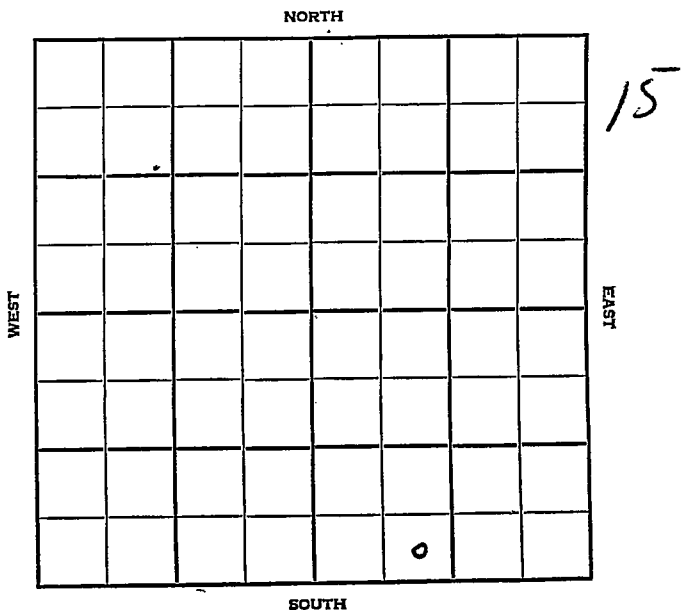

Rooks KANSAS

SEC.	TWP.	R.
5	10	18W
WELL NO.		
1 Williams		FARM
COMPANY		
K & E Drlg.		
CONTRACTOR		
Co. Tools		

\_\_\_\_\_ Ft. from N. Line  
 330 \_\_\_\_\_ Ft. from S. Line  
 \_\_\_\_\_ Ft. from E. Line  
 990 \_\_\_\_\_ Ft. from W. Line

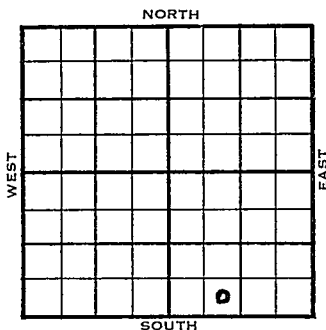

SE SW SE

	ELEVATION	REPORT
1955	2190'	
1/12	Spud 1-8-55 8" @ 199' Drlg. 2315'	
4/13	Spud 1-8-55 Oil Well TD 3790' 8" @ 199' Heeb. 3371', Tor. 3387' DST 3377-3401', opn 1 hr., rec. 190' ho & gem, 120' mo, 30' clean oil 1050# Lans. 3415' DST 3417-61, opn 1/2 hrs., rec. 30' mud, 570# DST 3728-42', opn 1 hr., rec. 210' mud, 215# Arb. 3777' TD 3790' 4" @ 3462' CO to 3435', 21/3394-99, 4/3401-02, S/3 bfph 3-hrs., 2 OOA S/9 bo 11 bwph 4 hrs. S/20 boph 60% wtr. -omp. 27bopd 78% wtr.	

COMPLETED



