


Section 5 Township 10 Range 19W

Well No. #1 Suter

Company L. B. Stable ford & H&E

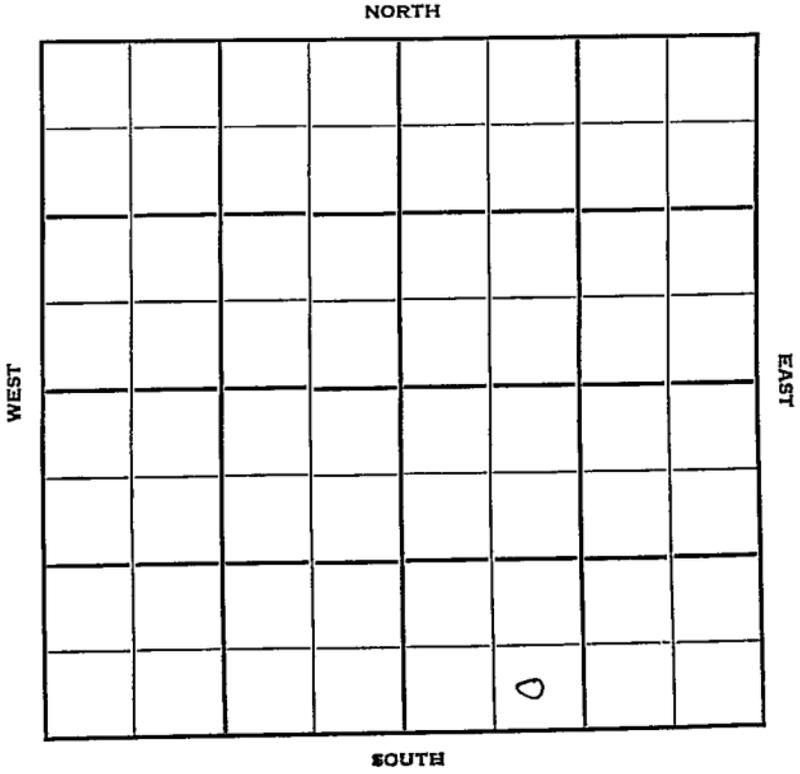

Rooks

KANSAS ✓

Sec. 5 Twp. 10 R. 19W

Well No. #1 Suter Farm

L. B. Stableford & K&E Company

K & E - Contr. Contractor


_____ Ft. from N. Line

330' Ft. from S. Line

_____ Ft. from E. Line

990' Ft. from W. Line

SE SW SE

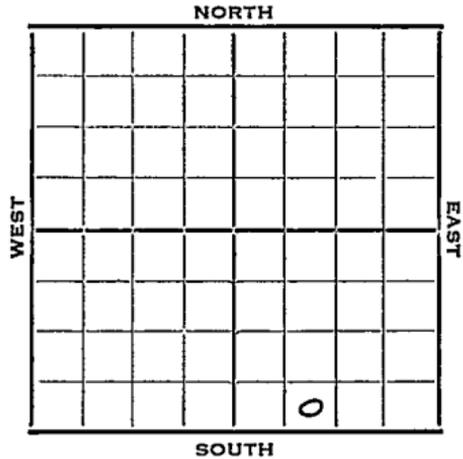

1952	Elev. 2224' REPORT
4/16 4/23	Location 8" @ 171 Anhy 1630' Drlg. 3090'
4/30	Heeb. 3415 Lans. 3452 DST 3614-28 1 hr. 60' VHOCM 1070# Cong. 3682 Arb. 3760? DST 3763-66 1 hr. 100' free oil 30' HOCM 860# RTD 3766 Sc 1 5" @ 3762
5/7	CO Schl. tops: Heeb. 3415 Lans. 3450 Arb. 3757 Schl. TD 3761 5" @ 3759 DP DD 3763 S/ 4 boph
5/14	POP
5/20	NR
5/28	NR
6/11	Spud 4-15-52 Oil well TD 3763: 8" @ 171 Anhy 1630' Heeb 3415' Lans. 3450' DST 3614-28 open 1 hr. rec 60' VHOCM Cong. 3682' Arb. 3757' DST 3763-66 open 1 hr. rec 100' free oil, 30' HOCM TD 3761' 5" @ 3759 DD 3763 S/4 BOPH Comp. 80 BOPD COMPLETED

