


Section 5 Township 10 Range 19W

Well No. #2 Sutor -

Company L. B. Stableford

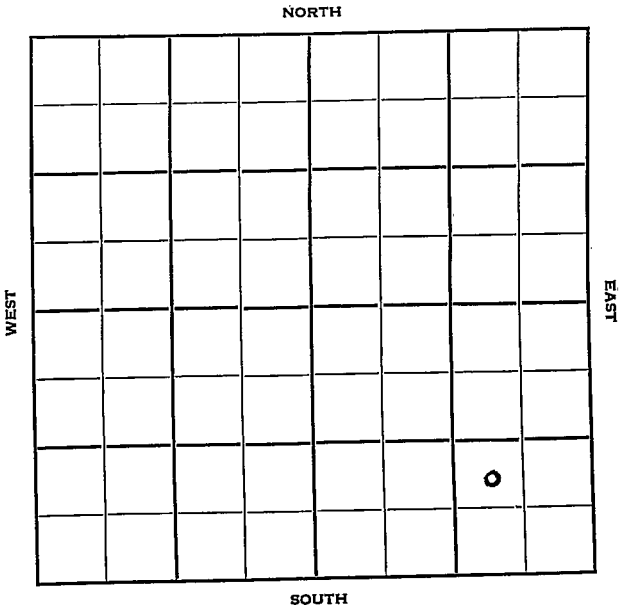

Sec. 5 Twp. 10 R. 19 W

Well No. # 2 Sutor Farm

L. B. Stableford Company

Beek Drlg. Contractor

Marcotte Pool


\_\_\_\_\_ Ft. from N. Line

990 Ft. from S. Line

990 Ft. from E. Line

\_\_\_\_\_ Ft. from W. Line

NW SE SE

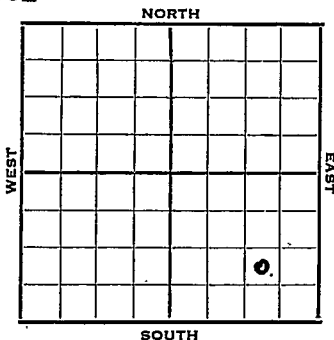

1952 Elev. 2225' REPORT

- 10/15 Spud 10-11-52  
8" @ 190  
Drlg. 1350'
- 10/22 Anhy 1627, Topeka 3210', Heeb 3421',  
KC 3458  
Drlg. 3502'
- 10/29 D & A - Hold
- 11/5 Spud 10-11-52  
D&A TD 3787' 8" @ 190'  
Anhy 1627 Top. 3210  
Heeb. 3421 KC 3458  
DST 3487-3502 open 1 hr. rec. 350'  
SW 1170#  
DST 3622-38 open 3/4 hr. rec. 12'  
mud O# TD 3787' D&A

**ABANDONED**



