

Section 5 Township 10 Range 20W

Well No. 2 Baldwin

Company Sinclair-Prairie

Palco

NORTH

	0						

WEST

EAST

SOUTH

12

KANSAS

Rocks ✓

Sec. 5 Twp. 10 R. 20W

Well No. #2 Baldwin Farm

Sinclair-Prairie Company


Palco Pool

330' Ft. from N. Line

_____ Ft. from S. Line

_____ Ft. from E. Line

990' Ft. from W. Line

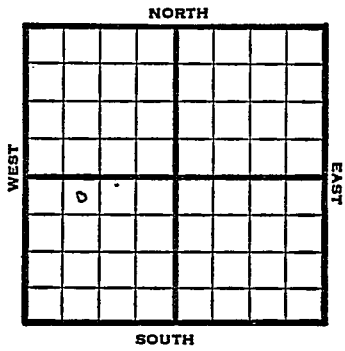

NE NW SW

1949

Elev 2266' REPORT

1/12
1/19

Location
 8" @ 1778'
 Drlg 1835'
 Drlg 3665'

1/26

2/2

Lansing 3538'
 Simpson 3824'
 Arbuckle 3836'
 TD 3908'

2/9

5" @ 3908'
 TD 3908'
 Arb. 3836'
 5" @ 3908'
 Perf 1000 acid
 Depth Pot 3000 Oil
 28° Gr.

Comp
COMPLETED

Map No. _____ Sec. 5 Twp. 10 R. 20W

Well No. 2 Baldwin

Sinclair-Prairie Company

FIRST REPORT Contractor

NE NW SW

SECTION PLAT

330 Ft. from N. Line

_____ Ft. from S. Line

_____ Ft. from E. Line

990 Ft. from W. Line

o			

Rooks County

Location X

Rig up _____

Drilling and Remarks:

RECORD

Cased _____ in., _____ ft.

Sand _____

Gas _____

Oil _____

Total Depth _____

PRODUCTION

1st 24 hrs. Nat. _____

1st 24 hrs. after shot _____

Gas _____ Cu. Ft.

Dry Hole _____

Abandoned _____

Date

JAN 12 1949 19

S. J. LEWIS Scout

Palco

Map No. R65 Sec. 5 Twp. 10 R. 20W

Well No. 2 Baldwin

Enclair-Prairie Company
COMPLETE

Contractor
NE NW SW. E. 2266
SECTION PLAT

_____ Ft. from N. Line

_____ Ft. from S. Line

_____ Ft. from E. Line

_____ Ft. from W. Line

	6		

Rocks (cont)

Location _____

Rig up _____

Drilling and Remarks:

cut 3836
5" 03905.
Prof.
100 acid
Test # 1 3000 oil
250 cu

RECORD

Cased _____ in., _____ ft.

Sand _____

Gas _____

Oil _____

Total Depth 3905

PRODUCTION

1st 24 hrs. Nat. _____

1st 24 hrs. after shot _____

Gas _____ Cu. Ft.

Dry Hole _____

Abandoned _____

Date

FEB 9 1949 19

S. J. LEWIS Scout