

Section 5 Township 10 Range 20WWell No. #5 BaldwinCompany Sinclair Oil & Gas Co.

NORTH

SOUTH

WEST

EAST

12

Rooks

KANSAS

5

10

20W

Sec. _____ Twp. _____ R. _____

Well No. #5 Baldwin Farm _____

Sinclair Oil & Gas Company _____

Murfin Drlg. - Contr. Contractor _____

Palco Pool


990' Ft. from N. Line

_____ Ft. from S. Line

_____ Ft. from E. Line

660' Ft. from W. Line

C S L NW SW

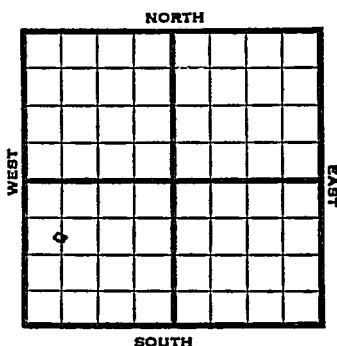

1951

Elev. 2272' REPORT

5/23

Location

6/27

Spud 5-27-51

Oil Well TD 3892

10" @ 191

Top 3306 Heeb. 3500

Tor. 3522 Lans. 3539

Cong. 3797 Simp 3824

Arb. 3842

TD 3892

5" @ 3892 GO to 3867

24/3842-46 Rec. 80' oil

S/5 boph 1500 A

S/200 bo 7 hr. Comp. 378 bopd

COMPLETED

County Rooks State Kansas
 Sec. 5 (Blk. 10) (Sur. 20W) (Twp.) Map No.
 Operator Sinclair Oil & Gas
 Well No. 5 Farm Baldwin
 Elev. Location C S L NW SW

990 Ft. From N Line SW660 Ft. From W Line Quarter1st. Report MAY 23 1951

Completion

Remarks


Spudding Date

Drlg. Data

Palco PoolLocation

J. E. TYRA

County Rooks State Kansas
 Sec. 5 (Blk. Twp.) 10 (Sur. Rge.) 20W Map No.
 Operator Sinclair Oil & Gas
 Well No. 5 Farm Baldwin
 Elev. 2272 Location C S L NW SW

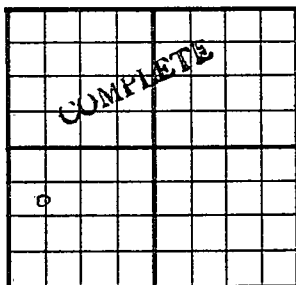

990 Ft. From N Line SW
660 Ft. From W Line Quarter
 1st. Report
 Completion JUN 27 1951
 Remarks Palco Pool
Murfin Drlg. - Contr.
 Spudding Date 5-27-51

Drlg. Data Oil well TD 3892
10" @ 191 Top. 3306 Heeb. 3500
Tor. 3522 Lans. 3539 Cong. 3797
Simp. 3824 Arb. 3842 TD 3892
5" @ 3892 CO to 3867 24/ 3842-46
Rec. 80' oil S/ 5 boph 1500 A
S/ 200 bo 7 hr. Comp. 378 bopd

J. E. TYRA