

Section 5 Township 10 Range 20N

Well No. 1 W.E. Baldwin

Company Sinclair-Prairie

Palco Pool

NORTH

| | | | | | | | |
|--|--|--|---|--|--|--|--|
| | | | | | | | |
| | | | | | | | |
| | | | | | | | |
| | | | | | | | |
| | | | 0 | | | | |
| | | | | | | | |
| | | | | | | | |
| | | | | | | | |

WEST

EAST

SOUTH

||

KANSAS

Rooks

Sec. 5 Twp. 10 R. 20W ✓

Well No. #1 W. E. Baldwin Farm

Sinclair-Prairie Company

Palco Pool


330' Ft. from N. Line

_____ Ft. from S. Line

330' Ft. from E. Line

_____ Ft. from W. Line

NE SW

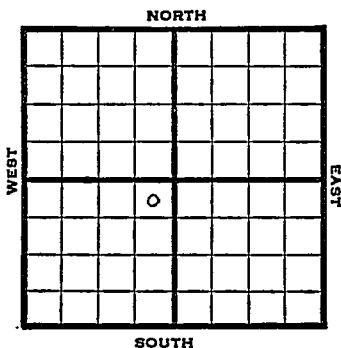

1948

Elev. 2252' REPORT

10/27 Location

11/3 RUR

11/10 8" @ 1304'

Drig. 2805'

11/16 Lansing 3525'

BKC 3750'

Simpson 3803'

Arbuckle 3830'

TD 3870'

5" @ 3870'

11/23 "

11/30 76 shots 3829-42

Swb 35 bbls oil 1 hr

1000 acid

12/8 "

12/15 "

12/22 Arb 3830'

5" @ 3870'

Perf.

1000 acid

Echo Pot. 2379 oil

Gr. 27°

TD 3870'

COMPLETED

Map No. _____ Sec. 5 Twp. 10 R. 20W

Well No. 1 W. E. Baldwin

Sinclair-Prairie Company

FIRST REPORT

Contractor

NE SW

SECTION PLAT

330 Ft. from N. Line

_____ Ft. from S. Line

330 Ft. from E. Line

_____ Ft. from W. Line

| | | | |
|--|--|--|--|
| | | | |
| | | | |
| | | | |
| | | | |
| | | | |

Rooks County

Location X

Rig up _____

Drilling and Remarks:

RECORD

Cased _____ in., _____ ft.

Sand _____

Gas _____

Oil _____

Total Depth _____

PRODUCTION

1st 24 hrs. Nat. _____

1st 24 hrs. after shot _____

Gas _____ Cu. Ft.

Dry Hole _____

Abandoned _____

Date

OCT 27 1948 19

S. J. LEWIS Scout

Map No. 65 Sec. 5 Twp. 10 R. 20W

Well No. 1 W. E. Baldwin

Sinclair-Prairie Company

COMPLETE

Contractor

NE SW

E 12252
SECTION PLAT

330 Ft. from N. Line

_____ Ft. from S. Line

330 Ft. from E. Line

_____ Ft. from W. Line

| | | | |
|--|--|--|--|
| | | | |
| | | | |
| | | | |
| | | | |

Rooks County

Location _____

Rig up _____

Drilling and Remarks:

Cr 73800
5" @ 3876
Prof.
10000 cu ft
Ech 7379 oil
272 cu

RECORD

Cased _____ in., _____ ft.

Sand _____

Gas _____

Oil _____

Total Depth 3876

PRODUCTION

1st 24 hrs. Nat. _____

1st 24 hrs. after shot _____

Gas _____ Cu. Ft.

Dry Hole _____

Abandoned _____

Date

DEC 22 1948 19

S. J. LEWIS

Scout