

Section 5 Township 10 Range 20-W

Well No. #1 Beinker

Company Skelly Oil
Palco

NORTH

				0			

SOUTH

WEST

EAST

10

KANSAS

Rooks

Sec. 5 Twp. 10 R. 20W ✓

Well No. #1 Beinker Farm

Skelly Oil Company

Palco Pool


330' Ft. from N. Line

_____ Ft. from S. Line

_____ Ft. from E. Line

330' Ft. from W. Line

NW SE

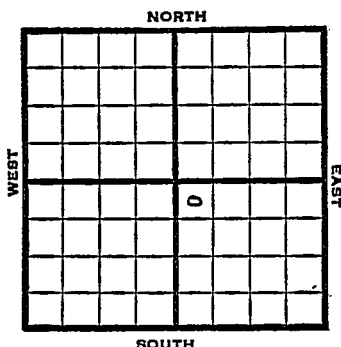

1948

Elev 2249' REPORT

12/8

Drlg. 370'

12/15

8" @ 413'

Drlg 2610'

12/22

Lansing 3530'

Arb. 3847'

TD 3855'

5" @ 3851'

"

12/29

1949

1/12

TD 3855'

Arb. 3847'

5" @ 3851'

Pump 592' oil Pot

27 1/4 Gr.

Comp

COMPLETED

Map No. _____ Sec. 5 Twp. 10 R. 20W

Well No. 1 Beinker

Skelly Oil

Company

FIRST REPORT

Contractor

NW SE


SECTION PLAT

330 Ft. from N. Line

_____ Ft. from S. Line

_____ Ft. from E. Line

330 Ft. from W. Line

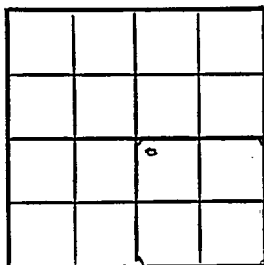

Rooks County

Location _____

Rig up _____

Drilling and Remarks:

drlg. 370

RECORD

Cased _____ in., _____ ft.

Sand _____

Gas _____

Oil _____

Total Depth _____

PRODUCTION

1st 24 hrs. Nat. _____

1st 24 hrs. after shot _____

Gas _____ Cu. Ft.

Dry Hole _____

Abandoned _____

Date

DEC 8 1948 19

S. J. LEWIS

Scout

Kansas

Map No. 65 Sec. 5 Twp. 10 R. 20WWell No. 1 Beinker

Skelly Oil

Company


COMPLETE

Contractor

NW SE

E12249

SECTION PLAT

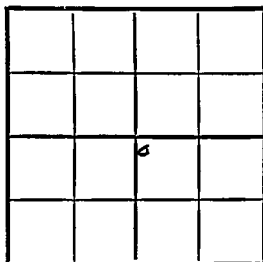330 Ft. from N. Line Ft. from S. Line Ft. from E. Line330 Ft. from W. Line

Rooks County

RECORD

Location Cased in., ft.Rig up Sand

Drilling and Remarks:

Gas Oil Total Depth 2835

PRODUCTION

1st 24 hrs: Nat. 1st 24 hrs: after shot Gas Cu. Ft.Dry Hole Abandoned

Date

JAN 12 1949

19

S. J. LEWIS

Scout

Cor 43849
5" @ 3851
Pump 592 oil Bt

274 lb

O. W. P. B.

County Reicks Elev. 2249
 Sec. 5 Twp. 10 Rge. 20W
 Company Skelly Oil Co.
 Farm Name Henry Beinke No. 1

TOPS

DEPTH

LOG

DATUM

Loc. in Sec.

Anb.

Tp.

H.

Tr.

Dg.

Bl.

L.

K.C.

B.K.C.

Ce.

C.

M.

M.

K.

Mz.

Ma.

V.

S.

S.

A.

R.

PE.

G.

T.D.

3486

3507

3524

tl

3524-28

NW NW SE

(OWPB)

Geol.

Contr.

Pool

Palco

FIRST REPORT
 DEC 12 1964
 0
 COMPLETE

3835

3855

Date Comm.

Old Info. 5" @ 3851, 592 BOPD no wtr.

New Info. Perf 60/3784-94, 500A, Bail 20,

GWPB, 4hrs, PB3640, Perf 30/3621-26 500A, Bail

31GWPB, 4hrs, PB3618, Perf 12/3600-94 & 30/3610

-15, Swb 9 BWPB 6hrs, PB 3580, Perf 54/3564-70

500A, Bail 10 GO/2BWPB, 2hrs, PB 3540, Perf 36/

3524-28, 500A, Swb 9 BO/3BW 8hrs, 2000A, P1st

BO/24 BW 24hrs, Er & Completion