


KANSAS Rocks

Section 5 Township 10 Range 20WWell No. 2 RennerCompany Lion OilRalco Pool
NORTH

KANSAS

Rooks

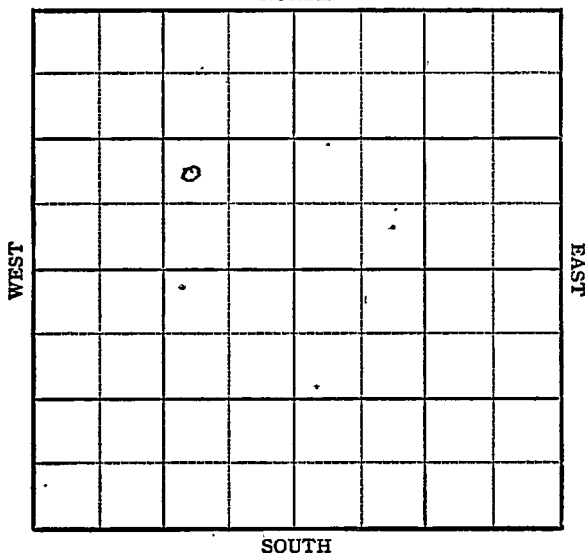

Sec. 5 Twp. 10 R. 20-W

Well No. #2 Renner Farm

Lion Oil

Company

Palco Pool


 Ft. from N. Line

990 Ft. from S. Line

990 Ft. from E. Line

 Ft. from W. Line

NW SE NW

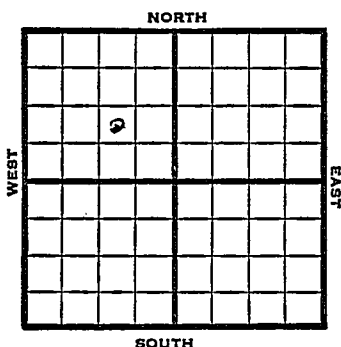

1948	Eli 2257'	REPORT
10/6	Location	
10/13	8" @ 154' Dr1 1150'	
10/19	Lansing 3524' Arb. 3825' TD 3828'	
10/26	5" @ 3826' TD 3835 500 acid Swb 86 oil 1 hr	
11/3	"	
11/10	TD 3835' Arb. 3825' 5" @ 3826' 500 acid Echo Pot 3000 Oil 28° Gr. Comp	
	COMPLETED	

Map No. _____ Sec. 5 Twp. 10 R. 20WWell No. 2 RennerLion Oil

Company

FIRST REPORT

Contractor

NW SE NW

SECTION PLAT

	o		

_____ Ft. from N. Line

990 Ft. from S. Line990 Ft. from E. Line

_____ Ft. from W. Line

Rooks County

Location X

Rig up _____

Drilling and Remarks:

RECORD

Cased _____ in., _____ ft.

Sand _____

Gas _____

Oil _____

Total Depth _____

PRODUCTION

1st 24 hrs. Nat. _____

1st 24 hrs. after shot _____

Gas _____ Cu. Ft.

Dry Hole _____

Abandoned _____

Date

OCT 6 1948

19

S. J. LEWIS Scout

Kansas

Map No. 65 Sec. 5 Twp. 10 R. 20WWell No. 2 Renner

Lion Oil

Company

COMPLETE

Contractor

NW SE NW

E 1.2257
SECTION PLAT Ft. from N. Line990 Ft. from S. Line990 Ft. from E. Line Ft. from W. Line

	0		

Rooks County

Location Rig up

Drilling and Remarks:


RECORD

Cased in., ft.Sand Gas Oil Total Depth 69825

PRODUCTION

1st 24 hrs. Nat. 1st 24 hrs. after shot Gas Cu. Ft.Dry Hole Abandoned

Date

NOV 10 1913

S. J. LEWIS

Scout