


Section 5 Township 10 Range 20-W

Well No. #7 Renner

Company Lion Oil  
Palco

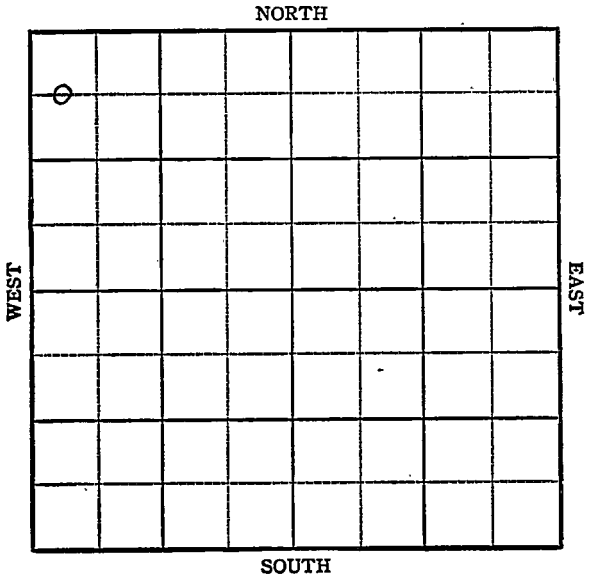

KANSAS

Rooks

Sec. 5 Twp. 10 R. 20W

Well No. #7 Renner Farm \_\_\_\_\_

Lion Oil

Company \_\_\_\_\_

Palco Pool


660' Ft. from N. Line

\_\_\_\_\_ Ft. from S. Line

\_\_\_\_\_ Ft. from E. Line

330' Ft. from W. Line

C W L NW NW

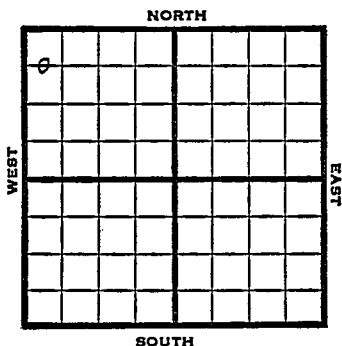

1948 Elev 2263' REPORT

- 12/8 Location
- 12/15 "
- 12/22 8" @ 154'
- Drlg 160'
- 12/29 Drlg 3805'
- 1/5     Lansing 3551'
- Arbuckle 3856'
- 5" @ 3857'
- TD 3861'
- Swb 2 bbl oil PH
- 1/12     500 acid sw & 6 oil PH
- 1/19     "
- 1/26     "
- 2/2     "
- 2/9     500 acid
- Swb 6 oil PH
- 2/16     "
- 2/23     "
- 3/2     "
- 3/9     TD 3861'
- Arb. 3856'
- 5" @ 3857'
- 5000 acid
- Pump 324 Oil Pot
- 30° r.
- Comp

Map No. \_\_\_\_\_ Sec. 5 Twp. 10 R. 20W

Well No. 7 Renner

Lion Oil Company

FIRST REPORT Contractor

C W L NW NW

SECTION PLAT

660 Ft. from N. Line

\_\_\_\_\_ Ft. from S. Line

\_\_\_\_\_ Ft. from E. Line

330 Ft. from W. Line

|   |  |  |  |
|---|--|--|--|
| 6 |  |  |  |
|   |  |  |  |
|   |  |  |  |
|   |  |  |  |

Rooks County

Location X

Rig up \_\_\_\_\_

Drilling and Remarks:

RECORD

Cased \_\_\_\_\_ in., \_\_\_\_\_ ft.

Sand \_\_\_\_\_

Gas \_\_\_\_\_

Oil \_\_\_\_\_

Total Depth \_\_\_\_\_

PRODUCTION

1st 24 hrs. Nat. \_\_\_\_\_

1st 24 hrs. after shot \_\_\_\_\_

Gas \_\_\_\_\_ Cu. Ft.

Dry Hole \_\_\_\_\_

Abandoned \_\_\_\_\_

Date

DEC 8 1948 19 \_\_\_\_\_

S. J. LEWIS Scout

Kansas

Map No. 65 Sec. 5 Twp. 10 R. 20W

Well No. 7 Renner

Lion Oil Company

**COMPLETE** Contractor

C W L NW NW

*E 12263*  
SECTION PLAT

660 Ft. from N. Line

         Ft. from S. Line

         Ft. from E. Line

330 Ft. from W. Line

|    |  |  |  |
|----|--|--|--|
| 0, |  |  |  |
|    |  |  |  |
|    |  |  |  |
|    |  |  |  |

Rooks County

Location                                 

Rig up                                 

Drilling and Remarks:

*Per 3856*  
*5" @ 3857*  
*5000 cu ft*  
*Only 324 oil Per*  
*30° S*

**RECORD**

Cased          in.,          ft.

Sand                                 

Gas                                 

Oil                                 

Total Depth 3861

**PRODUCTION**

1st 24 hrs. Nat.                         

1st 24 hrs. after shot                         

Gas                          Cu. Ft.

Dry Hole                         

Abandoned                         

Date

MAR 9 1949 19

S. J. LEWIS Scout