


Section 5 Township 10 Range 20W

Well No. 5 Renner

Company Lion Oil

Palco Pool
NORTH

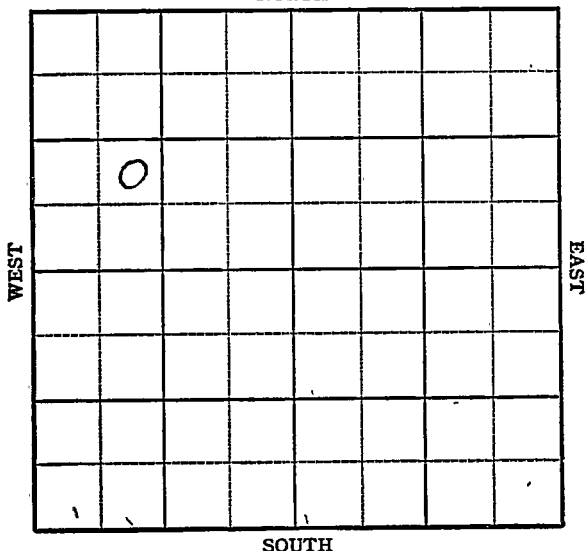

5

Sec. 5 Twp. 10 R. 20W ✓

Well No. 5 Renner Farm

Lion Oil Company

Palco Pool


_____ Ft. from N. Line

990 Ft. from S. Line

_____ Ft. from E. Line

990 Ft. from W. Line

NE SW NW

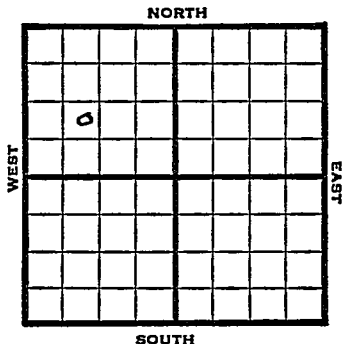

1948 Elev. 2264' REPORT

11/17	Location
11/23	8" @ 165'
11/30	Arb. 3834'
	TD 3837'
12/8	5" @ 2835'
	TD 3843'
	500 acid
	Swb 43 bbls oil PH
12/15	"
12/22	Arb 3834'
	5" @ 3835'
	500 acid
	Echo Pot. 2332 oil
	Gr. 27°
	TD 3843'

COMPLETED

Map No. _____ Sec. 5 Twp. 10 R. 20W

Well No. 5 Renner

Lion Oil Company

FIRST REPORT Contractor

NE SW NW

SECTION PLAT

_____ Ft. from N. Line

990 Ft. from S. Line

_____ Ft. from E. Line

990 Ft. from W. Line

Rooks County

Location X

Rig up _____

Drilling and Remarks:

RECORD

Cased _____ in., _____ ft.

Sand _____

Gas _____

Oil _____

Total Depth _____

PRODUCTION

1st 24 hrs. Nat. _____

1st 24 hrs. after shot _____

Gas _____ Cu. Ft.

Dry Hole _____

Abandoned _____

Date

NOV 17 1948

S. J. LEWIS

Scout

