

Section 5 Township 10 Range 20^WWell No. #6 RennerCompany Lion Oil
Palco

0								

NORTH

WEST

EAST

SOUTH

5

KANSAS

Rooks

Sec. 5 Twp. 10 R. 20W

Well No. #6 Renner Farm

Lion Oil

Company

Palco Pool

 Ft. from N. Line

660'


 Ft. from S. Line

 Ft. from E. Line

330'

 Ft. from W. Line

C W L SW NW

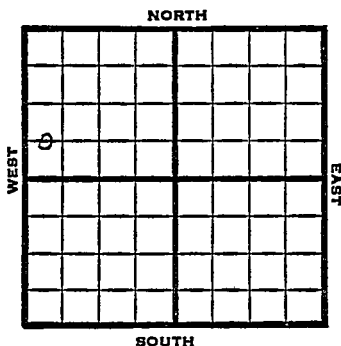

1948

Elev 2271'

R E P O R T

12/8

8" @ 1160'

Drlg. 2000'

12/15

Drlg 3550'

12/22

Lansing 3542'

Arb 3839-57'

TD 3857-57'

5"@ 3843'

12/29

Swb 70 bbls oil 1½ hrs.

1949

1/12

TD 3857'

Arb. 3839'

5"@ 3843'

Depth Pot 3000 oil

27+ Gr.

Comp

COMPLETED

Kansas

Map No. _____ Sec. 5 Twp. 10 R. 20WWell No. 6 RennerLion Oil


Company

FIRST REPORT

Contractor

C W L SW NW

SECTION PLAT

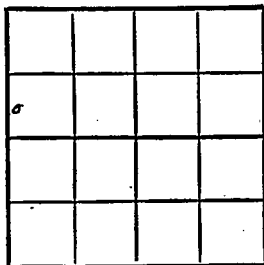

_____ Ft. from N. Line

660

_____ Ft. from S. Line

_____ Ft. from E. Line

330

_____ Ft. from W. Line

Rooks County

Location _____

Rig up _____

Drilling and Remarks:

8" @ 1160drlg. 2000

RECORD

Cased _____ in., _____ ft.

Sand _____

Gas _____

Oil _____

Total Depth _____

PRODUCTION

1st 24 hrs. Nat. _____

1st 24 hrs. after shot _____

Gas _____

Cu. Ft. _____

Dry Hole _____

Abandoned _____

Date

DEC 8 1948 19S. J. LEWIS

Scout

Kansas

Map No. 65 Sec. 5 Twp. 10 R. 20WWell No. 6 Renner


Lion Oil

Company

COMPLETE

Contractor

C W L SW NW

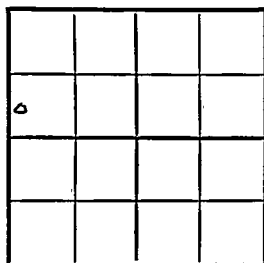E. 2271
SECTION PLAT

Ft. from N. Line

660 Ft. from S. Line

Ft. from E. Line

330 Ft. from W. Line

Rooks County

RECORD

Location

Cased _____ in. _____ ft.

Rig up

Sand _____

Drilling and Remarks:

Gas _____

Oil /Total Depth 3852

PRODUCTION

1st 24 hrs. Nat. _____

1st 24 hrs. after shot _____

Gas _____ Cu. Ft.

Dry Hole _____

Abandoned _____

Date

JAN 12 1949 19

S. J. LEWIS

Scout

Cert 38075-03843Depth 3800 oil22 1/2 ft