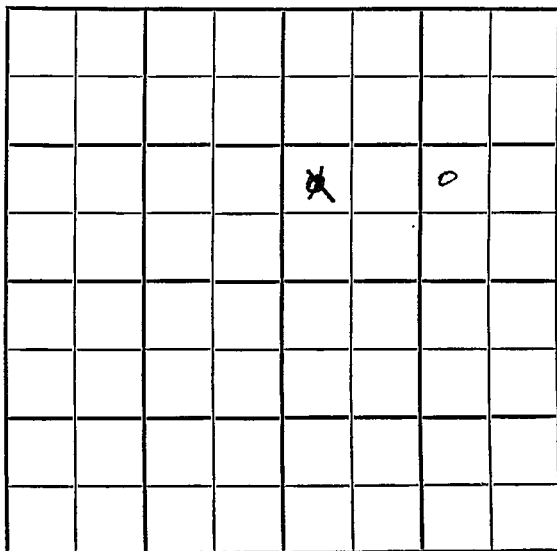


Section 5 Township 10 Range 21WWell No. 1 RudmanCompany Jones, Shelburne & Farmer

NORTH

WEST

EAST



SOUTH

Graham

Kansas

SEC.	TWP.	R.
5	10	21W ✓

WELL NO.

I Rudman

FARM

COMPANY

Jones, Shelburne & Farmer

CONTRACTOR

J-S-F - Contr

Smith Pool

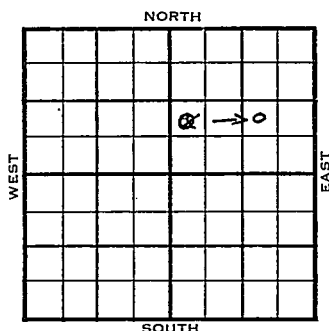
_____ Ft. from N. Line

990 _____ Ft. from S. Line

990 _____ Ft. from E. Line

~~330~~ _____ Ft. from W. Line

NW SE NE

~~NW SW NE~~

1954

ELEVATION

REPORT

2292'

6/2

Spud 5-29-54

8" @ 165 Drlg. 2370

6/9

Spud 5-29-54 D & A TD 3900

8" @ 165 Any 1725 Heeb 3489

Lans. 3530'

DST 3610-19 open 20 min rec 4' mud 50'

DST 3722-46 open 3/4 hr rec 8' mud

1090# B KC 3759 Cong 3865

Simp. 3887 TD 3900 D & A

ABANDONED

J. G. McGEHEE

Kansas

Map No. _____ Sec. 5 Twp. 10 R. 21W

Well No. 1 Rudman

Jones, Shelburne & Farmer Company

CORRECTION Contractor

NW SE NE

SECTION PLAT

			0

_____ Ft. from N. Line

990 Ft. from S. Line

990 Ft. from E. Line

_____ Ft. from W. Line

Graham County

Location _____

Rig up _____

Drilling and Remarks:

Reported
NW SW NE

RECORD

Cased _____ in., _____ ft.

Sand _____

Gas _____

Oil _____

Total Depth _____

PRODUCTION

1st 24 hrs. Nat. _____

1st 24 hrs. after shot _____

Gas _____ Cu. Ft.

Dry Hole _____

Abandoned _____

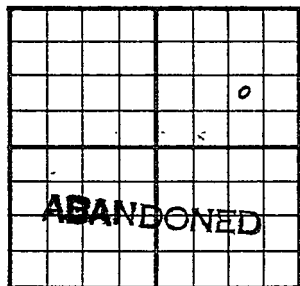
Date

JUN

8 1954 19

J. G. McGEHEE

Scout

County Graham State KansasSec. 5 (Blk.) 10 (Sur.) 21W Map No.Operator Jones, Shelburne & FarmerWell No. 1 Farm RudmanElev. 2292 Location NW SE NE990 Ft. From S Line NE990 Ft. From E Line Quarter

1st. Report

Completion JUN 9 1954Remarks Smith PoolJ-S-F - Contr.Spudding Date 5-29-54Drlg. Data D & A TD 39008" @ 165 Anhy 1725 Heeb. 3489Lans. 3530 DST 3610-19 open 20 min.Rec. 4' mud 50# DST 3722-46 open3/4 hr. Rec. 8' mud 1090# B KC 3759Cong. 3865 Simp. 3887 TD 3900D & A

J. G. McGEHEE