

Section 5 Township 10 Range 21W

Well No. #1 Rudeman

Company Westgate-Greenland

NORTH

2

				0			

WEST

EAST

SOUTH

Sec. 5 Twp. 10 R. 21W

Well No. #1 - Rudeman- Farm

Westgate-Greenland Company

Jackson Drlg. Contractor

Dinning Pool


330' Ft. from N. Line

\_\_\_\_\_ Ft. from S. Line

\_\_\_\_\_ Ft. from E. Line

330' Ft. from W. Line

NW NW NE

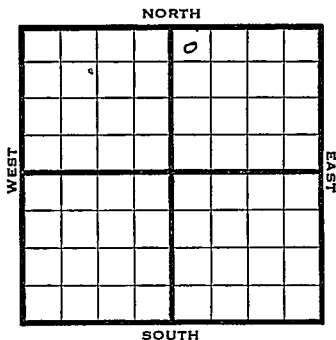

1950

Elev. 2286' REPORT

4/26

Spud 4-21-50  
Drlg. "

5/31

9-5/8" @ 198'  
Anhy 1754'  
Heeb 3467'  
Lans. 3510'  
DST 3588-98  
opn 1 hr  
Rec. 100' OCM  
1880' salt wtr.  
Arb 3844-48 SO  
5" @ 3845'  
Swab 35 BOPH  
Comp. 3000 BOPH — ? BOPD  
TD 3848'

**COMPLETED**

Map No. \_\_\_\_\_ Sec. 5 Twp. 10 R. 21W

Well No. 1 Rudeman

Westgate-Greenland Company

Jackson Drlg. Contractor

NW NW NE

330 Ft. from N. Line

\_\_\_\_\_ Ft. from S. Line

\_\_\_\_\_ Ft. from E. Line

330 Ft. from W. Line

SECTION PLAT



Graham County

Location \_\_\_\_\_

Rig up \_\_\_\_\_

Drilling and Remarks:

Spud 4-21-50

drlg.

RECORD

Cased \_\_\_\_\_ in., \_\_\_\_\_ ft.

Sand \_\_\_\_\_

Gas \_\_\_\_\_

Oil \_\_\_\_\_

Total Depth \_\_\_\_\_

PRODUCTION

1st 24 hrs. Nat. \_\_\_\_\_

1st 24 hrs. after shot \_\_\_\_\_

Gas \_\_\_\_\_ Cu. Ft.

Dry Hole \_\_\_\_\_

Abandoned \_\_\_\_\_

Date

APR 26 1951

J. E. TYRA Scout

Map No. \_\_\_\_\_ Sec. 5 \_\_\_\_\_ Twp. 10 \_\_\_\_\_ R. 21<sup>W</sup>


Well No. 1 Rudeman

Westgate-Greenland Company

Contractor

E1. 2286  
SECTION PLAT

330 Ft. from N. Line  
\_\_\_\_\_ Ft. from S. Line  
\_\_\_\_\_ Ft. from E. Line  
330 Ft. from W. Line

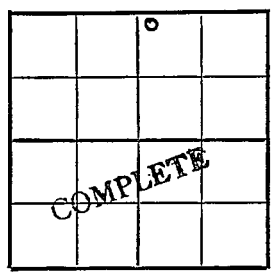

Graham

Location \_\_\_\_\_

Rig up \_\_\_\_\_

Drilling and Remarks:

*9 7/8" C 198  
Army 1754  
Neel 3467  
Lans. 3510  
DST 3588-98  
open 1 hr.  
Rec. 100' acm*

RECORD

Cased \_\_\_\_\_ in., \_\_\_\_\_ ft.  
Sand \_\_\_\_\_  
Gas \_\_\_\_\_  
Oil \_\_\_\_\_  
Total Depth 3848

PRODUCTION

1st 24 hrs. Nat. \_\_\_\_\_  
1st 24 hrs. after shot \_\_\_\_\_  
Gas \_\_\_\_\_ Cu. Ft.  
Dry Hole \_\_\_\_\_  
Abandoned \_\_\_\_\_

*1880' salt water*  
Date \_\_\_\_\_

MAY 31 1950

19

J. E. TYRA

Scout

Arb. 3844-48 so

Doc' c 3845

Swab 35 boph

Comp. 3000 boph

Misc.
Pierce Map
France Map
Tracings
Land WAMP
Land Small Map
Scout Cards

DATE

BY

APR 6 1950

TIME

RECORD

DATE

BY

DATE

BY


DATE

BY

DATE