Graham

KANSAS


FORM 51 25M 3-49 PETROL

Section 5 Township 10 Range 21-W

Well No. #2 Rudman

Company Westgate Greenland

2

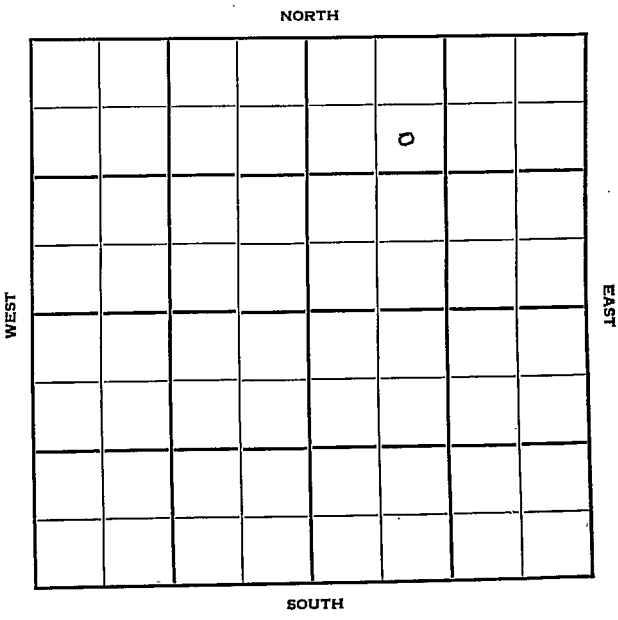

FORM 252-B
10M 9-49 PETROL

Graham KANSAS

Sec. 5 Twp. 10 R. 21W

Well No. #2 Rudman Farm

Westgate Greenland Company

Contractor

Smith


990' Ft. from N. Line

Ft. from S. Line

Ft. from E. Line

990' Ft. from W. Line

SE NW NE

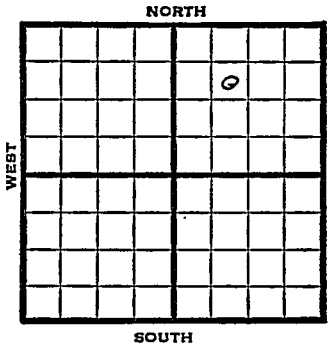

1950	Elev 2269 REPORT
5/31	Pits.
7/19	10 3/4" @ 210 Anhy 1756 Heeb 3462 KC 3500 Cong 3788 Arb 3843-48 TD S/5 boph FU 1900' oil 24 hr Pump 12 boph Comp 360 bopd 5% wtr Completed COMPLETED

Form 26 200 Bks. 11-49 Petrol

Smith

Kansas

Map No. _____ Sec. 5 Twp. 10 R. 21W

Well No. 2 Rudman

Westgate Greenland Company

Contractor

SE NW NE

990 Ft. from N. Line

_____ Ft. from S. Line

_____ Ft. from E. Line

990 Ft. from W. Line

Graham

SECTION PLAT



Location

Rig up

Drilling and Remarks:

Pitts

RECORD

Cased _____ in., _____ ft.

Sand

Gas

Oil

Total Depth

PRODUCTION

1st 24 hrs. Nat.

1st 24 hrs. after shot

Gas _____ Cu. Ft.

Dry Hole

Abandoned

Date

MAY 31 1950

19 J. E. TYRA Scout

Form 26 200 Bks. 11-49 Petrol

Kansas

Smith Pool

Map No. _____ Sec. 5 Twp. 10 R. 21W

Well No. 2 Rudman


Westgate-Greenland Company

Contractor

SE NW NE

El. 2269

SECTION PLAT

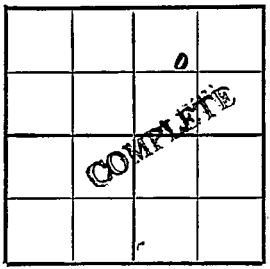

990 Ft. from N. Line

Ft. from S. Line

Ft. from E. Line

990 Ft. from W. Line

Graham County

Location

Rig up

Drilling and Remarks:

10 3/4" @ 210

Anhy 1756

Heeb. 3462

KC 3500

Cong. 3788

Arb. 3843-48 TD

S/ 5 boph

RECORD

Cased _____ in., _____ ft.

Sand

Gas

Oil

Total Depth 3848

PRODUCTION

1st 24 hrs. Nat.

1st 24 hrs. after shot

Gas _____ Cu. Ft.

Dry Hole

Abandoned

Date

JUL 19 1950 19

J. E. IYRA Scout

DFU 1900' oil 24 hr.

Pump 12 boph

Comp. 360 bopd 5% water

Scout Cards
Land Small Map
Land Wall Map
Tracings
France Map
Pierce Map
Misc.

AUG 1 1950