


Section 5 Township 10 Range 21W

Well No. 5 Smith

Company Natural Gas & Oil & GRA

27

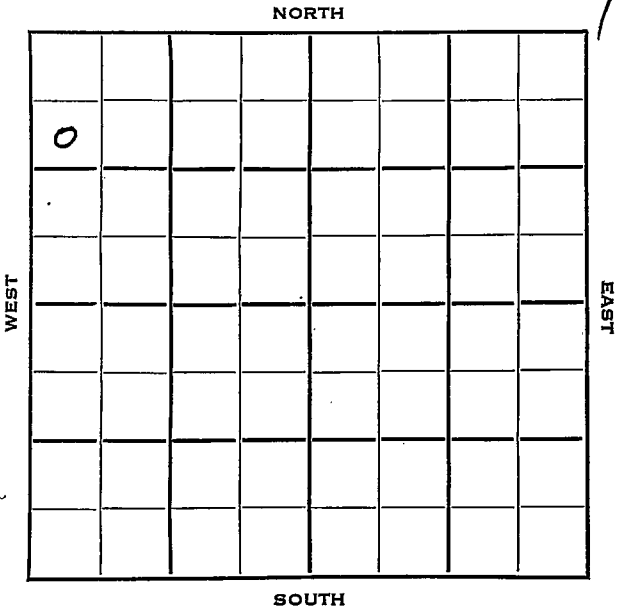

Graham

KANSAS

SEC.	TWP.	R.
5	10	21W

WELL NO.

COMPANY

#5 Smith

FARM

CONTRACTOR

Natural Gas & Oil & CRA

Co. Tools.

Smith-Denning Pool

NORTH


990 Ft. from N. Line

Ft. from S. Line

Ft. from E. Line

330 Ft. from W. Line

SW NW NW

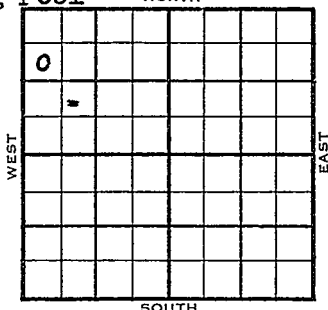

1953

ELEVATION

REPORT

2307'

9/16

Spud 9-15-53

9/23

10" @ 160' w/170 sks
Drlg. 3440'

9/30

Spud 9-15-53
 D & A TD 3910' 10" @ 160
 Heb 3500 Tor. 3529 Lans 3542
 DST 3544-90 open 1 hr rec 185' WCM
 DST 3696-3733 open 1 hr rec 25' mud
 DST 3608-35 open 1 hr rec 1290' SO
 & GCSW 1170# B KC 3775'
 Marm. 3835' Cong. 3867' Simp. 3881
 Arb. 3895'
 DST 3896-3902 open 1 hr rec 75' wtr.
 800# DST 3901-10 open 1 hr rec 330'
 sul. wtr. 1250#
 TD 3910' D & A

ABANDONED

County Graham State Kansas
 Sec. 5 (Blk.) 10 (Sur.) 21W Map No.
 Operator Natural Gas & Oil & GRA
 Well No. 5 Farm Smith
 Elev. Location SW NW NW

0							

990 Ft. From N Line NW
330 Ft. From W Line Quarter

1st. Report SEP 16 1953

Completion

Remarks

Co. tools

Spudding Date 9-15-53

Drlg. Data Smith-Denning Pool

J. G. McGEHEE

County Graham State Kansas
 Sec. 5 (Blk. 10) (Sur. 21W) Map No.
 Operator Natural Gas & Oil & CRA
 Well No. 5 Farm Smith
 Elev. 2307 Location SW NW NW

0					

ABANDONED

990 Ft. From N Line NW
330 Ft. From W Line Quarter
 Ist. Report
 Completion SEP 30 1953
 Remarks Smith-Denning Pool
Co tools
 Spudding Date 9-15-53

Drlg. Data D & A TD 3910
10" @ 160 Heeb. 3500 Tor. 3529
Lans. 3542 DST 3544-90 open 1 hr.
Rec. 185' wcm DST 3696-3733 open 1 hr.
Rec. 25' mud DST 3608-35 open 1 hr.
Rec. 1290' so & gcsw 1170# B KC 3775
Marm. 3835 Cong. 3867 Simp. 3881
Arb. 3895 DST 3896-3902 open 1 hr.
Rec. 75' wtr. 800# DST 3901-10
open 1 hr. Rec. 330' sul. wtr. 1250#
TD 3910

D & A

J. G. McGEHEE