

Section 5 Township 10 Range 21 WWell No. # 4 C. W. SmithCompany Westgate-Greenland

NORTH

	0						

WEST

EAST

SOUTH

Graham

KANSAS



Sec. 5 Twp. 10 R. 21 W

Well No. # 4 C. W. Smith Farm

Westgate Greenland Company

Saturn Contractor


330 Ft. from N. Line

_____ Ft. from S. Line

_____ Ft. from E. Line

990 Ft. from W. Line

NE NW NW

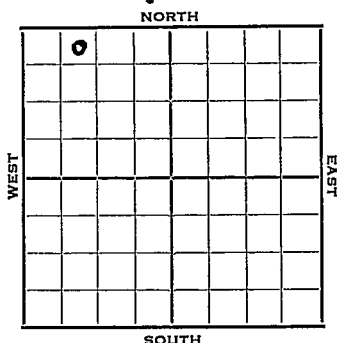

1952

Elev. 2295'

REPORT

6/11

Spud 6-10-52

8" @ 195'

Drlg. 600'

6/18

DST 3448-55, 1 hr, 232' fluid SW & M

Heeb 3480' Tor. 3500' Lans. 3522'

DST 3558-65, 1 hr, 90' HO & GCM,

270' muddy gassy oil, 210' SW

Drlg. 3612'

6/25

DST 3719-29, 1/2 hr, 15' M

Cong. 3848' Simp. 3858' Arb. 3878'

DST 3881-85, 1/2 hr, 15' SOCM 850#

TD 3885' 5" @ 3881'

7/2

DP 3885 500 A HFW Set plug 3595

12/3557-61 SSO &W 500 A

S/100 BW & 44 BO 8 hrs. POP

7/9

NR

7/17

"

7/23

"

7/30

Spud 6-10-52

Oil well TD 3885' 8" @ 195'

DST 3448-55 open 1 hr. rec 232' fluid

SW & mud. Heeb 3480' Tor. 3500'

Lans. 3522'

DST 3558-65 open 1 hr. rec 90' HO &

GCM, 270' muddy gassy oil, 210' SW

DST 3719-29 open 1/2 hr. rec 15' mud

1000 A

OVER

1952
7/30

(Information continued)

Cong. 3848' Simp. 3858' Arb. 3878'
DST 3881-85 open $\frac{1}{2}$ hr. rec 15' SOC^W
850# TD 3885' 5" @ 3881' DP to
3885' 500 A HFW SP 3595
12/3557-61 SSO & W 500 A S/100 BW
44 BQ 8 hr.
Comp. 72 BOPD 70% water.

COMPLETED

County Graham State KansasSec. 5 (Blk. Twp.) 30 (Sur. Rge.) 21W Map No.Operator Westgate GreenlandWell No. 4 Farm C. W. SmithElev. Location NE NW NW

0							

330 Ft. From N Line NW990 Ft. From W Line Quarter1st. Report JUN 11 1952

Completion

Remarks

Saturn - Contr.Spudding Date 6-10-52

Drlg. Data

8" @ 195 Drlg. 600

J. G. McGEHFE

County Graham State KansasSec. 5 (Blk.) 10 (Sur.) 21W Map No.Operator Westgate-GreenlandWell No. 4 Farm C. W. SmithElev. 2295 Location NE NW NW

0					

330 Ft. From N Line NW990 Ft. From W Line Quarter

1st. Report

Completion JUL 30 1952

Remarks

Saturn - Contr.Spudding Date 6-10-52Drlg. Data Oil well TD 38858" @ 195 DST 3448-55 open 1 hr.Rec. 232' fluid sw & mud Heeb. 3480Tor. 3500 Lans. 3522 DST 3558-65open 1 hr. Rec. 90' ho & gcm 270'muddy gassy oil 210' sw DST 3719-29open $\frac{1}{2}$ hr. Rec. 15' mud 1000 ACong. 3848 Simp. 3858 Arb. 3878DST 3881-85 open $\frac{1}{2}$ hr. Rec. 15' socm850# TD 3885 5" @ 3881 DP to 3885500 A HFW SP 3595 12/ 3557-61SSO & W 500 A S/ 100 bw 44 bo 8 hr.Comp. 72 bopd 70% water