


Graham

KANSAS

SECTION 5 TOWNSHIP 10S RANGE 23W

WELL NO. #1 Clifford

COMPANY Cook & Galloway & Nate Appleman

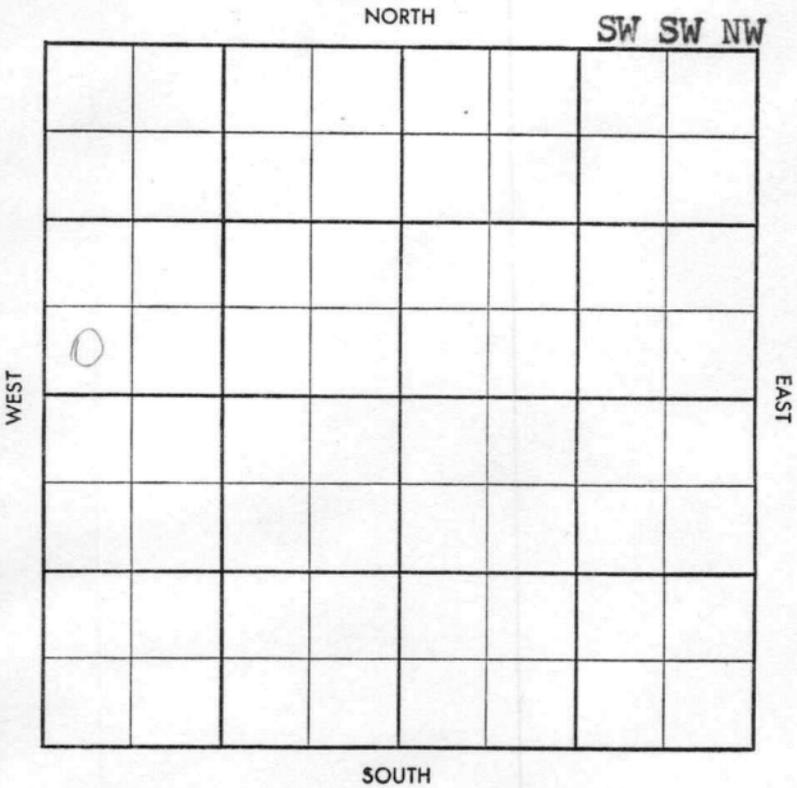

Twp NO Pool Na
 Co. ✓ Facet 120

5

S-513-B

County Graham Elev. 2446 & B 2443 D
 Sec. 5 Twp. 10 Rge. 23W
 Company Cook & Galloway & Nate Appleman
 Farm Name Clifford No. 1

TOPS	DEPTH	LOG	DATUM
Anh.	<u>2050</u>		
Tp.			
H.	<u>3754</u>		
Tr.	<u>3777</u>		
Dg.			
B.L.			
L.	<u>3792</u>		
K.C.			
B.K.C.	<u>4026</u>		
Ce.			
C.			
M.			
M.			
K.			
Mz.			
Mq.			
V.			
S.			
S.			
A.			
R.			
Pf.			
G.			
T.D.	<u>4030</u>		

Loc. in Sec. SW SW NW
 Geol. _____
 Contr. C & G #1
 Pool Hoof NW

ABANDONED
 0
 SEP 3 '58

Date Comm. 8-23-58 8" 213/150
 WORT AUG 27 '58 Ø 2770 SEP 3 '58 DST 3938
-60 30" 8'M BHP 0/20" DST
3955-80 30" 15'M FPO-0 BHP
0-90/20" log

D6A

C.
L.
No.
Sec.
T.
R.