

Rooks


KANSAS

SECTION 6 TOWNSHIP 10 RANGE 17 W

WELL NO. #1 Posegate

COMPANY Jones, Shelburne & farmer

NORTH

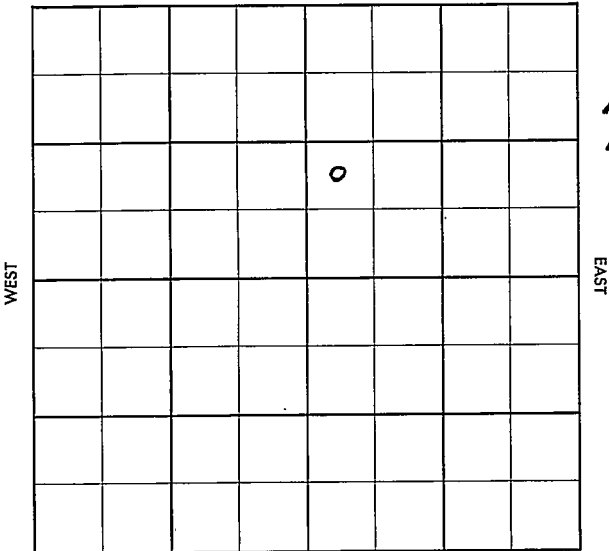

SOUTH

Rooks

KANSAS

SEC.	TWP.	R.
6	10	17W

WELL NO.

#1 Posegate

FARM

COMPANY

Jones, Shelburne & Farmer

CONTRACTOR

Co. tools

Plainville


Ft. from N. Line

Ft. from S. Line

Ft. from E. Line

Ft. from W. Line

NW SW NE

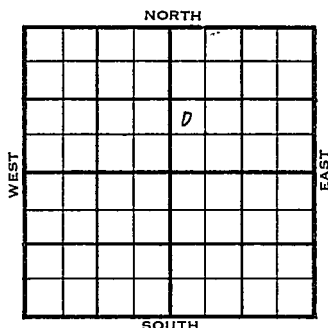

1956

ELEVATION

REPORT


2-1

Comm. 1-28-56
8" @ 166/150
Drlg. 2003
Anh. 1388

County Rooks Elev. _____
 Sec. 6 Twp. 10 Rge. 17W
 Company Jones, Shelburne & Farmer
 Farm Name Posegate No. I

TOPS	DEPTH	LOG	DATUM	Loc. in Sec.
Anh.	1388			NW SW NE
TP.				
H.				
Tr.				
Dg.				
BL.				
L.				Geol. _____
K.C.				Contr. _____
B.K.C.				Co. tools _____
Ce.				Pool _____
C.				Plainville
M.				
M.				
K.				
Mz.				
Ma.				
V.				
S.				
S.				
A.				
R.				
PE.				FIRST REPORT
G.				FEB 1 '56
T.D.				

Date Comm. 1-28-56
8" @ 166/150 drlg. 2003

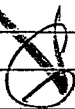

County Rooks Elev. 2095
 Sec. 6 Twp. 10 Rge. 17W
 Company Jones, Shelburne & Farmer
 Farm Name Posegate No. 1

TOPS	DEPTH	LOG	DATUM	Loc. in Sec.
Ant.	1388			NW SW NE
Top.				
H.	3237			
Tr.	3257			
Dg.				
Bl.				
L.	3279		1184	Geol.
K.C.				
BXC.	3505		1410	Contr.
Ce.				
C.	3527		1432	Co. tools
M.				
M.				Pool
K.				Plainville
Mr.				
Mo.				
V.				
S.				
S. 3457	3575		1480	
* 50' DOL.	3593		1498	
* B.C.	3613		1518	
PE				
G.				
TD	3623			

Date Comm. 1-28-56 FEB 15 1956
 8" • 166/150 drlg. 2003 FEB 8 '56

DST 3357-80 1hr rec 75' MSW

BHP 955/20 #3385 FEB 15 '56

No Log DST 3467-81 30" rec
 10' Md BHP 140/20"

12 5' 2

et al

ABANDONED