


Rooks

KANSAS

SECTION 6 TOWNSHIP 10S RANGE 17W

WELL NO. #1 P.D. Posegate "A"

COMPANY Davis Bros. - Tulsa

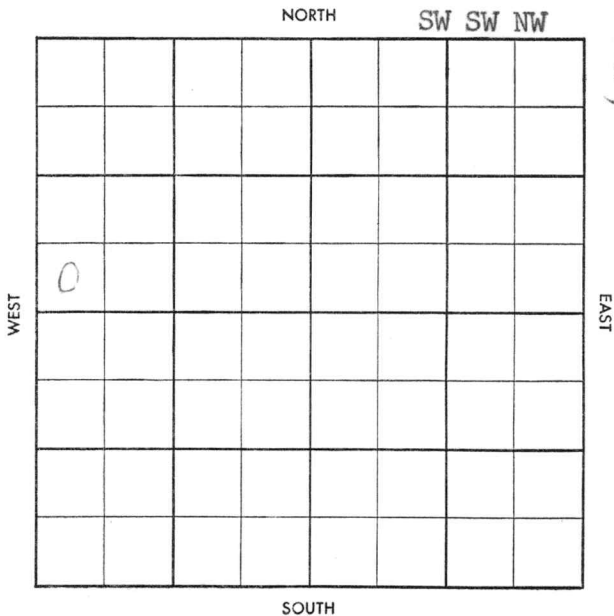

~~XXXX~~  
~~XXXX~~

County Rooks Elev. \_\_\_\_\_  
 Sec. 6 Twp. 10S Rge. 17W  
 Company Davis Bros.-Tulsa  
 Farm Name P. D. Posegate "A" No. 1

TOPS	DEPTH	LOG	DATUM
Anh.			
Tp.			
H.			
Tr.			
Dg.			
B.L.			
L.			
K.C.			
B.K.C.			
Ce.			
C.			
M.			
M.			
K.			
Mz.			
Mq.			
V.			
S.			
S.			
A.			
R.			
Pf.			
G.			
T.D.			

Loc. in Sec. \_\_\_\_\_

**SW SW NW**

Geol. \_\_\_\_\_

Cont. **Transit #2**

Pool \_\_\_\_\_

**Plainville**



Date Comm. 6-30-58  
set surf 8" at 174 w/135; D 887

Co.

Lse.

No.

Sec.

T.

R.

Twp. ✓ Pool ✓  
 Co. ✓ Facet ✓

5-513-B

County Rooks Elev. 2120KB 2118DF  
 Sec. 6 Twp. 10S Rge. 17W  
 Company Davis Bros.-Tulsa  
 Farm Name P. D. Posegate "A" No. 1

TOPS	DEPTH	LOG	DATUM
Anh.	1430		
Tp.	3048		
H.	3264	3262	
Tr.	3284	3282	
Dg.			
B.L.			
L.	3307	3305	
K.C.			
B.K.C.	3529	3529	
Ce.			
C.	3544	3543	
M.			
M.			
K.			
Mz.			
Mq.			
V.			
S.	3599	3599	
S.			
A.	3652	3651	
R.			
Pf.			
G.			
T.D.	3705		

Loc. in Sec. SW SW NW  
 Geol. \_\_\_\_\_  
 Contr. Transit #2  
 Pool Plainville  
 COMPLETE  
 AUG 27 '58

Date Comm. 6-30-58  
 set surf 8" at 174 w/135; D 887

JUL 10 '58 DST 3187-3257 1hr 360  
 MSW FP 100-250 BHP 1400-  
 1300/20" DST 3269-3332 1hr  
 25'M FP 20-20 BHP 570/20"  
 DST 3330-80 2hrs 210' gip 150  
 HOGEM FP 20-60 BHP 900/20"  
 DST 3379-3402 1hr 13'M FP  
 20-30 BHP 785/20 Ø 3402

JUL 16 '58

DST 3400-30 1hr 41' M SW  
 FP 20-40 BHP 685-940/20"  
 DST 3427-60 1hr 25' M FP 20-30  
 BHP 50-50/20" DST 3451-75  
 1hr 13' M FP 20-20 BHP 40-40/20"  
 DST 3473-35 37 2hr 40' 00 M  
 FP 20-30 BHP 880-70/20"  
 DST 3607-15 1hr 18' 00 SPK M  
 1' line oil FP 10-15 BHP 260-35/20"

Ran 5 experiments W & L + ST

Log 4 1/2 3700/260 JUL 23 58 WOCT

JUL 30 58

CO 3665 12/3600-03

(K) FU 200' fld 2590 oil 32°

12 hrs \$ 50 + 5 to 10 g M + W

ph 3 hrs 300A Plug 3590 FU

220' fld 2590 oil 12 hrs Plug

3590 12/3521-24 AUG 6 58

AUG 13 58

16/3466-70 8/3474

~~76~~ 8/3478-80 16/3481-85

Plug 3500 13) \$ 2 1/2 BFP 8590

oil ~~CO 3590~~ P 20 BP

4590 oil 12 hrs AUG 20 58 P 20 BOT

1 BW 12 hrs

~~3466-~~

~~strip P + 120 BP + 290 BP + 290 BP + 290 BP~~

AUG 27 58

P 40 BOP + 2 BW

Lsg

6-10-17W

sw sw nw