


Section 6 Township 10 Range 19-W

Well No. #1 Pywell

Company Sinclair Oil

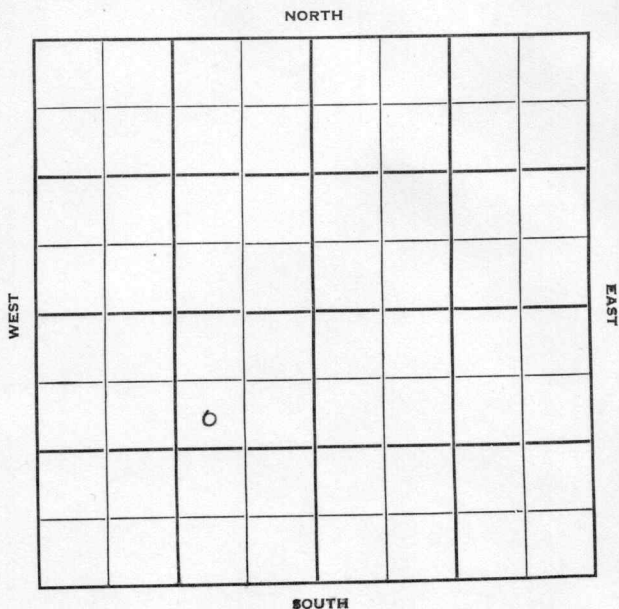

6

19W

Sec. _____ Twp. _____ R. _____

#1 Pywell

Well No. _____ Farm _____

Sinclair Oil

Company _____

Contractor _____


990' Ft. from N. Line

_____ Ft. from S. Line

990' Ft. from E. Line

_____ Ft. from W. Line

SW NE SW

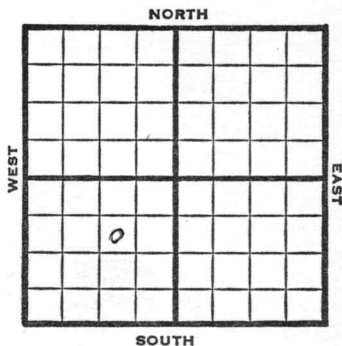

1950

Elev 2232'

REPORT

4/5 8-5/8" @ 300'
Drlg. 1460'

4/19 TD 3975'
8 5/8" @ 300'
Topeka 3254'
Heeb 3460'
Lans 3499'
Cong 3740'
Arb. 3938'
D&A
Aband.

ABANDONED

Kansas

Map No. _____ Sec. 6 Twp. 10 R. 19W

Well No. 1 Pywell

Sinclair Oil Company

Contractor _____

SW NE SW

990 Ft. from N. Line

_____ Ft. from S. Line

990 Ft. from E. Line

_____ Ft. from W. Line

SECTION PLAT

FIRST REPORT

Rooks County

Location _____

Rig up _____

Drilling and Remarks:

8 5/8" @ 300

drlg. 1460

RECORD

Cased _____ in., _____ ft.

Sand _____

Gas _____

Oil _____

Total Depth _____

PRODUCTION

1st 24 hrs. Nat. _____

1st 24 hrs. after shot _____

Gas _____ Cu. Ft.

Dry Hole _____

Abandoned _____

Date

APR 5 1950 19

J. E. TYRA Scout

Kansas

Map No. _____ Sec. 6 Twp. 10 R. 19W

Well No. 1 Pywell

Sinclair Oil Company

Contractor

SW NE SW

E/ 2232
SECTION PLAT

990 Ft. from N. Line

_____ Ft. from S. Line

990 Ft. from E. Line

_____ Ft. from W. Line



Rooks County

Location _____

Rig up _____

Drilling and Remarks:

8 5/8" @ 300
Topeka 3254
Hub 3460
Lans 3499
Conq 3740
arb 3938

RECORD

Cased _____ in., _____ ft.

Sand _____

Gas _____

Oil _____

Total Depth 3975

PRODUCTION

1st 24 hrs. Nat. _____

1st 24 hrs. after shot _____

Gas _____ Cu. Ft.

Dry Hole _____

Abandoned _____

Date

D+A

APR 19 1950

19

J. E. TYRA

Scout