


Section 6 Township 10 Range 20W

Well No. 5 - Hinkhouse

Company Gulf Oil

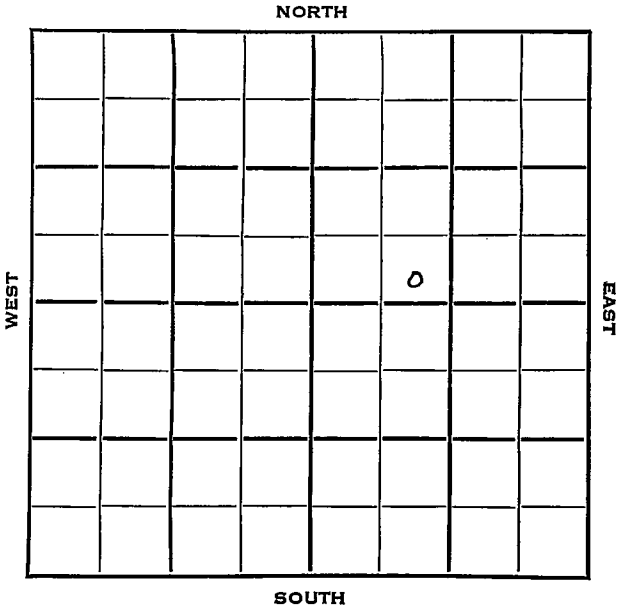

Rooks  
10

20W

Sec. 6 Twp. \_\_\_\_\_ R. \_\_\_\_\_

#5 Hinkhouse

Well No. \_\_\_\_\_ Farm \_\_\_\_\_

Gulf Oil

Company \_\_\_\_\_

Contractor \_\_\_\_\_

\_\_\_\_\_ Ft. from N. Line

330


\_\_\_\_\_ Ft. from S. Line

\_\_\_\_\_ Ft. from E. Line

990

\_\_\_\_\_ Ft. from W. Line

SE SW NE

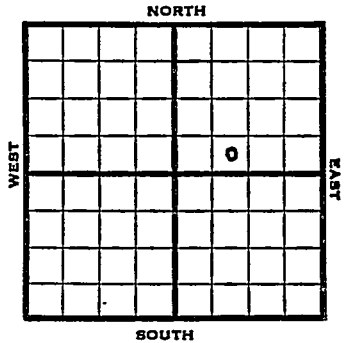

1952 Elev. 2268

REPORT

12/23 Location

12/25 Location

1/1 Location

1/8 Anhy 1780 8" @ 1786 Ø3305

1/15 Heeb 3493, Tor 3516, Lans 3535  
DST 3613-35, 1/2 hrs, 1460' wtr,  
Arb 3835  
RTD 3838,  
5" @ 3838

1/22 DD 3844' 1 1/4 BO plus 1 GWPH 4 hrs.  
500 A No help DD 3846'

1/29 S/16 1/2 BO + 16 gw 4 hrs.  
S/30 BO + 1/2 BW 7 hrs. POP

2/5 NR  
2/12 NR

2/18 Spudding Date 12/29/52  
Oil Well TD 3846

Anhy 1780 8" @ 1786 Heeb. 3493  
Tor. 3516 Lans. 3535 DST 3613-35  
open 1/2 hr. Rec. 1460' wt5. & SGC  
1250# Arb. 3835 TD 3838 5" @ 3836  
DD 3844 1 1/4 bo 1 gwph 4 hr. 500A  
DD 3846 S/16 1/2 bo 16 gw 4 hr. S/  
30 bo 1/2 bw 8 hr. comp. 208 bopd 2 bw

COMPLETED



