


Section 6 Township 10 Range 20 W

Well No. # 3 Frank Inkhouse

Company Gulf

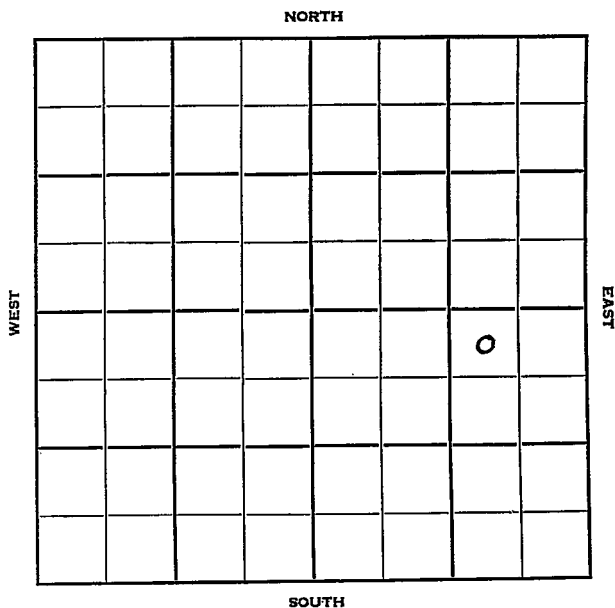

Sec. 6 Twp. 10 R. 20 W

Well No. # 3 Frank Inkhouse Farm

Gulf Company

Fields Contractor

Palco


330 Ft. from N. Line

_____ Ft. from S. Line

990 Ft. from E. Line

_____ Ft. from W. Line

NW NE SE

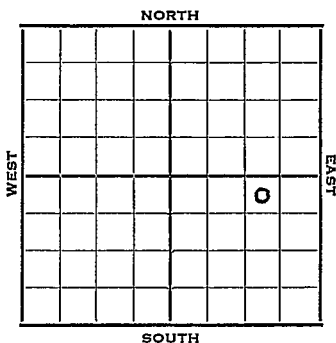

1952

Elev. 2266' REPORT

2/27

Spud 2-24-52
8" @ 217' WOC

3/5

Anhy 1775'
Drlg. 3555'

3/12

Heeb 3496' Tor 3518' Lans. 3536'
DST 3619-50', 1 hr, 1565' SW
Cong. 3796' Simp. 3820'
Arb. 3838' RTD 3845' SD
5" @ 3839' WOC

3/19

"

3/25

DP CO to 3845 S/ 2 BOPH 6 hrs.
500 A S/ 66 1/2 BO 6 hrs.

Testing

4/1

Testing

4/9

"

4/23

"

4/30

Testing

5/7

Spud 2-24-52
Oilwell TD 3845' 8" @ 217
Anhy 1775' Heeb 3496' Tor. 3518'
Lans. 3536'
DST 3619-50 open 1 hr. rec 1565' SW
Cong. 3796' Simp. 3820' Arb. 3838'
TD 3845' 5" @ 3839 CO to 3845
S/2 BOPH 6 hr. 500 A
S/66 1/2 BO 6 hr.
Comp. 237 BOPD

COMPLETED

