


Section 6 Township 10 Range 20W

Well No. #1 Hinkhouse

Company D. G. Hansen

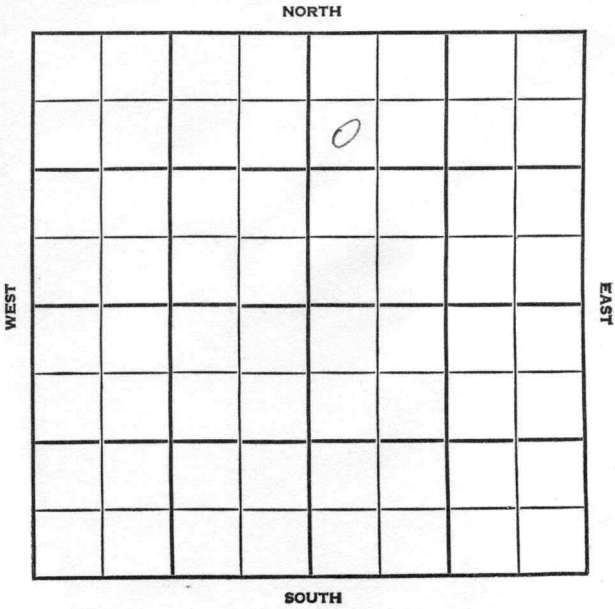

SEC. 6	TWP. 10	R. 20W
-----------	------------	-----------

WELL NO. #1 Hinkhouse FARM

COMPANY D.G. Hansen

CONTRACTOR C & G Drlg.

Palco


\_\_\_\_\_ FT. FROM N. LINE

\_\_\_\_\_ FT. FROM S. LINE

\_\_\_\_\_ FT. FROM E. LINE

\_\_\_\_\_ FT. FROM W. LINE

SW NW NE

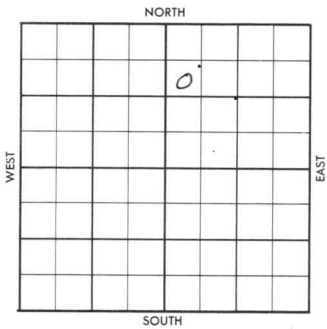

1956	ELEVATION 2288'	REPORT
------	--------------------	--------

7-3 Comm. 6-27-56  
8" @ 165 w/140  
Drlg. 2850'.  
Anh. 1781'.

7-11 D & A  
Tp. 3327'; H. 3531'; Tr. 3555';  
L. 3571'; BKC 3795'; C. 3859';  
A. 3922';  
TD 3926'

**ABANDONED**

County Rooks Elev. \_\_\_\_\_  
 Sec. 6 Twp. 10 Rge. 20W  
 Company D. G. Hansen  
 Farm Name Hinkhouse No. 1

TOPS	DEPTH	LOG	DATUM
Anh.	1781		
Tr.			
H.			
Tr.			
Dg.			
Bl.			
L.			
K.C.			
B.K.C.			
Ce.			
C.			
M.			
M.			
K.			
Mz.			
Mq.			
V.			
S.			
S.			
A.			
R.			
PE.			
G.			
T.D.			

Loc. in Sec. SW NW NE  
 Geol. \_\_\_\_\_  
 Contr. C & G Drlg.  
 Pool Palco  

	0	

FIRST REPORT  
JUL 3 '56

Date Comm. 6-27-56  
8" @ 165/140 drlg. 2850

Recd 1 1 JUL  
 D.R.

Co. No. Sec. T. R.

County Polk Elev. 2288  
 Sec. 6 Twp. 10 Rge. 20W  
 Company D. Hansen  
 Farm Name Winkhouse No. 1

TOPS	DEPTH	LOG	DATUM	Loc. in Sec.
Anh.	1787			SW 1/4 NE
Tp.	3327			
H.	3531			
Tr.	3555			
Dg.				
Bl.				
L.	3571			Geol.
K.C.				Contr.
B.K.C.	3795			C & G Drl.
Ce.				
C.	3859			Pool
M.				Palco
M.				
K.				
Mz.				
Mo.				
V.				
S.				
S.				
A.	3922			<div style="border: 1px solid black; padding: 5px; text-align: center;"> </div>
R.				
PE.				
G.				
TD.	3926			

Date Comm. 6-27-56 JUL 1 1 1956

8" @ 165/140 drl., 2850 JUL 11 '56

D&A.

Co.  
Lse.  
No.  
Sec.  
T.  
R.