

Section 6 Township 10 Range 20W

Well No. 1 Hinkhouse


Company Gulf

Palco

NORTH

WEST

EAST

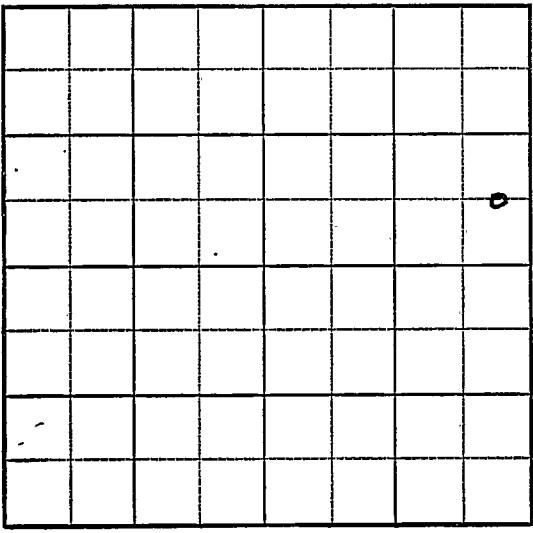

SOUTH

KANSAS

Rooks

Sec. 6 Twp. 10 R. 20W

Well No. #1 Hinkhouse Farm

Gulf

Company

Palco Pool

Ft. from N. Line

660'


Ft. from S. Line

330'

Ft. from E. Line

Ft. from W. Line

C E L S E N E

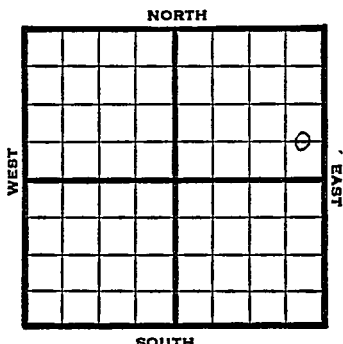

1949

Elev. 2278' REPORT

1/19

Location

1/26

Drlg 1796'

2/2

8" @ 1806'

Drlg. 2570'

2/9

Lansing 3569'

Conglomerate 3859'

Arbuckle 3989'

Drlg 3999'

2/16

Arb 3989'

TD 4019'

ABANDONED

Kansas

Map No. _____ Sec. 6 Twp. 10 R. 20WWell No. 1 HinkhouseGulf

Company

FIRST REPORT

Contractor


C E L S E N E

SECTION FLAT

_____ Ft. from N. Line

660 Ft. from S. Line330 Ft. from E. Line

_____ Ft. from W. Line

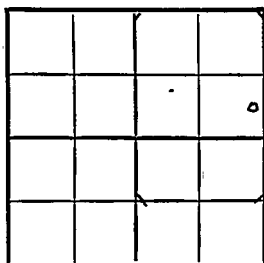Rooks County

RECORD

Location X

Rig up _____

Drilling and Remarks:

Cased _____ in., _____ ft.

Sand _____

Gas _____

Oil _____

Total Depth _____

PRODUCTION

1st 24 hrs. Nat. _____

1st 24 hrs. after shot _____

Gas _____ Cu. Ft.

Dry Hole _____

Abandoned _____

Date

JAN 1 9 1949 19S. J. LEWIS

Scout

Map No. K65 Sec. 6 Twp. 10 R. 20W

Well No. 1 Hinkhouse

Gulf Company

ABANDONED

C E L S E N E Contractor E. J. 2278

SECTION PLAT

 Ft. from N. Line

660 Ft. from S. Line

330 Ft. from E. Line

 Ft. from W. Line

			0

Rooks County

Location

Rig up

Drilling and Remarks:

Per X 3988

RECORD

Cased in., ft.

Sand

Gas

Oil

Total Depth 4019

PRODUCTION

1st 24 hrs. Nat.

1st 24 hrs. after shot

Gas Cu. Ft.

Dry Hole

Abandoned

Date

FEB 16 1949 19

S. J. LEWIS Scout