


Section 6 Township 10 Range 20W

Well No. #3 Tucker

Company Heathman & Co.

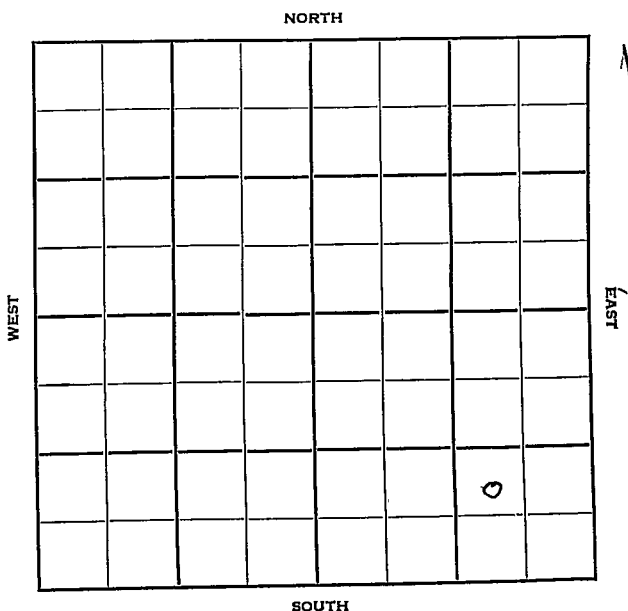

Rooks

Sec. 6 Twp. 10 R. 20W

Well No. #3 Tucker Farm

Heathman & Co. Company

B & B Drlg. - Contr. Contractor

Palco Pool


 Ft. from N. Line

990' Ft. from S. Line

990' Ft. from E. Line

 Ft. from W. Line

NW SE SE

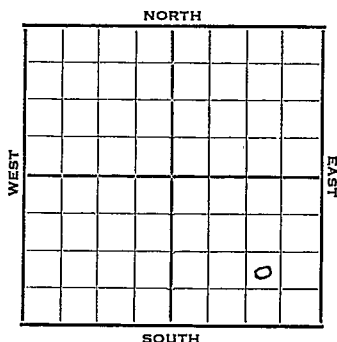

1952 Elev. 2269' REPORT

2/20 Location

3/5 8" @ 152'
Anhy 1780'
Drlg. 3303'

3/12 Topeka 3291'
DST 3318-30, 1/2 hr, 12' M 830#
Heeb 3495' Tor 3518' Lans. 3535'
DST 3537-42, 1/2 hr, 5' M SSO 770#
DST 3610-25, 3/4 hr, 90' OCM, 120'
free oil, 1000#
DST 3624-45, 20 mins, 140' O & GCM,
60' gassy oil, 300' wtr cut oil 0#
DST 3662-77', 40 mins, 25' OCM 190#
DST 3726-38, 40 mins, 30' OCM, 1020#
B KC 3758' Cong. 3795' Simp. 3828'
Arb. 3847' RTD 3851 1/2' Schl
5" @ 3849' WOC

3/19 WOCT

3/25 "

4/1 DD to 3855 500 A S/ 1 boph
for 2 hrs. DD 3862 TD S/ 2 boph
for 12 hrs. 4500 A S/ 3 boph
& 5 gal W PH

4/9 NR

4/23 P/2 1/2 BOPH

4/30 NR

OVER

1952

5/7

Spud 2-26-52

Oil well TD 3862' 8" @ 152

Anhy 1780' Top 3291'

DST 3318-30 open $\frac{1}{2}$ hr, rec 12' mud

Heeb 3495' Tor. 3518' Lans. 3535

DST 3537-42 open $\frac{1}{2}$ hr. rec 5' mud

DST 3610-25 open $\frac{3}{4}$ hr. rec 90' OCM
120' free oil

DST 3624-45 open 20 min, rec 140' O
& GCM, 60' gassy oil, 300' water cut
oil

DST 3662-77 open 40 min, rec 25' OCM

DST 3726-38 open 40 min, rec 30' OCM

B KC 3758' Cong. 3795' Simp. 3828'

Arb. 3847'

TD 3851' 5" @ 3849' DD 3855'

500 A S/1 BOPH 2 hr. DD 3862'

S/2 BOPH 12 hr. 4500 A

S/3 BOPH 5 GWPH P/2 $\frac{1}{2}$ BOPH

Comp. 108 BOPD

COMPLETED

County Rooks State Kansas
 Sec. 6 (Blk. 10 (Sur. 20 Map No.
 (Twp.) (Rge.)

Operator Heathman & Co.

Well No. **3** Farm **Tucker**

Elev. 2269 Location NW SE SE

FIRST REPORT

990 Ft. From S Line SE

990 Ft. From W. Line Quarter

1st. Report FEB 20 1952

Completion

Remarks

B & B Drlg. - Contr.


Spudding Date _____

Drig. Data Palco Pool

Location

J. G. McGEHEE

County Rooks State Kansas
 Sec. 6 (Blk. 10 (Sur. 20W Map No. Twp. Rge.)
 Operator Heathman & Co.
 Well No. 3 Farm Tucker
 Elev. 2269 Location NW SE SE

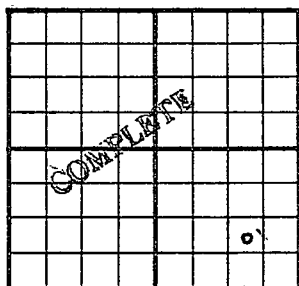

990 Ft. From S Line SE
990 Ft. From E Line Quarter
 Ist. Report
 Completion MAY 7 1952
 Remarks Palco Pool
B & B Drlg. - Contr.
 Spudding Date 2-26-52

Drlg. Data Oil well TD 3862
8" @ 152 Anhy 1780 Top. 3291
DST 3318-30 open $\frac{1}{2}$ hr. Rec. 12'
mud Heeb. 3495 Tor. 3518
Lans. 3535 DST 3537-42 open $\frac{1}{2}$ hr
Rec/ 5' mud DST 3610-25 open $\frac{3}{4}$
hr. Rec. 90' ocm 120' free oil
DST 3624-45 open 20 min. Rec.
140' o & gem 60' gassy oil
300' water cut oil. DST 3662-77
open 40 min. Rec. 250' ocm
DST 3726-38 open 40 min. Rec.
30' ocm B KC 3758 Cong. 3795
Simp. 3828 Arb. 3847 TD 3851

J. G. McGEHEE

Drlg. Data

5" @ 3849 DD 3855 500 A

S/ 1 boph 2 hr. DD 3862

S/ 2 boph 12 hr. 4500 A

S/ 3 boph 5 gwph P/ 2 $\frac{1}{2}$ boph

Comp. 108 bopd

Misc.
Pledge Map
Field Map
Findings
Land Wall Map
Land Small Map
Scout Cards

May 15 1952