


DX 78-1 Rooks

Section 6 Township 10 Range 20W

Well No. #2 Wolf

Company D. G. Hansen

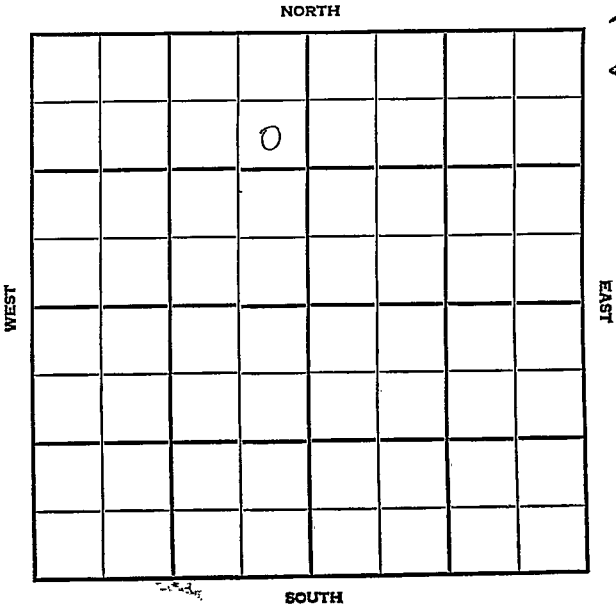

3

SEC. 6	TWP. 10	R. 20 W
-----------	------------	------------

WELL NO.

#2 Wolf

FARM

COMPANY

D.G. Hansen

CONTRACTOR

C&G Drlg.

Palco


____ FT. FROM N. LINE

____ FT. FROM S. LINE

____ FT. FROM E. LINE

____ FT. FROM W. LINE

SE NE NW

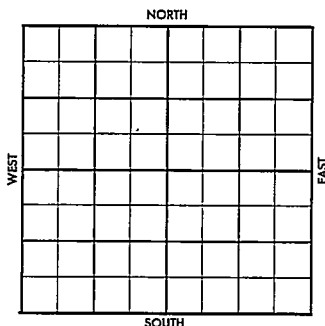

	ELEVATION	REPORT
1956	2272'	

5-29

Comm. 5-23-56
 8" @ 170 w/125
 Drlg. 3045
 Anh. 1764'

7-18

DST 3631-41 op 60 min, rec. 380' SW,
 BHP 1150#.
 DST 3863-68 op 60 min, 240 GIP, rec.
 220' oil, 30' MCO, BHP 420/20".
 5 1/2" @ 3863 w/100
 DD 3869
 S/ 1 BOPH, no/wtr.,
 S/ 7 BOPH, no/wtr., 4 hrs.
 P/ 80 BOPD / 3% wtr.
 Tp. 3312'; H. 3514'; Tr. 3538';
 L. 3554'; BKG 3777'; Cgl. 3832';
 S. 3850'; A. 3862';
 TD 3869';

COMPLETED

County	<u>Rocks</u>	Elev.	
Sec.	<u>6</u>	Twp.	<u>10</u>
Company	<u>D. G. Hansen</u>	Rge.	<u>20W</u>
Farm Name	<u>Wolf</u>	No.	<u>2</u>

TOPS	DEPTH	LOG	DATUM	Loc. in Sec.
Anh.	<u>1764</u>			<u>SE NE NW</u>
Tr.				
H.				
Tr.				
Dg.				
Bl.				
L.				
K.C.				Geol.
B.K.C.				Contr.
Ce.				<u>C & G Drilg.</u>
C.				
M.				Pool
M.				<u>Palco</u>
K.				
Mz.				
Mo.				
V.				
S.				
S.				
A.				
R.				
PE.				
G.				
T.D.				

Date Comm. 5-23-56

8" @ 170/125 drlg. 3045

21 MAY 1956

3.51

County Rooks Elev. 2272
 Sec. 6 Twp. 10 Rge. 20W
 Company D. G. Hansen
 Farm Name Wolf No. 2

TOPS	DEPTH	LOG	DATUM	Loc. in Sec.
Anh.	1761			SE NE NW
TP.	3312			
H.	3514			920 NL
Tr.	3524 38			
Dg.				
Bl.				
L.	3554			Geol.
K.C.				Contr.
B.K.C.	3777			
Ce.	3832			C & G Drlg.
C.				
M.				Pool
M.				Palco
Mz.				
Me.				
V.				
S.	3850			
S.				
A.	3862			
R.				
PE.				
G.				
T.D.	3869			

7	0		
COMPLETE			
JUL	18	1956	

Date Comm. 5-23-56

8" @ 170/125 drlg. 3045 JUN 6 '56

DST 3631-41 (60) rec 380' SW

BHP 1150

DST 3863-68 (60) 240' 61P rec

220' D. 1 30' MCQ BHP 420 (20)

TD 3868 5 1/4" 3863 / 100

WOC JUN 13 '56 JUN 20 '56 MICT DD 3869

B 1 Boph no/w/ta & 7 Boph

no/w 4 hrs. P.O.P. JUN 27 '56 JUL 3 '56

FORM 513-1 SUNRA

6-10-20W SE NE NW

JUL 11 '56 JUL 18 '56

Ph P. 80 Bopdt

390 wt

6-10-20 DE NE NW