

Section 6 Township 10 Range 21WWell No. 1 ~~Beecher~~ BeecherCompany Barnett Drlg. 2

NORTH

			X	0			

WEST

EAST

SOUTH

Graham

KANSAS

Sec. 6 Twp. 10 R. 21 W ✓

Well No. # 1 Beecher Farm

Barnett Drlg.

Company

Contractor

Wildcat

330

Ft. from N. Line

Ft. from S. Line


~~330~~

Ft. from E. Line

330

Ft. from W. Line

NW NW NE
NE NE NW

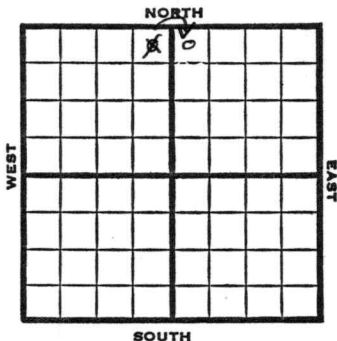

Deep Rock farmout

1951

Elev. 2301' REPORT

8/1

Spud 7-30-51
8" @ 144 WOC

9/19

Spud 7-30-51
Oil well TD 3882' 8" @ 144
Anhy 1770' Heeb 3486' KC 3525'
DST 3549-76' open 1 hr. rec 780' SW
DST 3592-3620 open 1 hr. rec 480'
gas, 125' OCM, 120' VHOCM
B KC 3754' Simp. 3865' Arb. 3880-82
5" @ 3881' TD 3882' FU 2147' oil
6 hr.
Comp. 195 BOPD

COMPLETED

County Graham State KansasSec. 6 (Blk.) 10 (Sur.) 21W Map No.Operator Barnett Drlg.Well No. 1 Farm BeetcherElev. Location NE NE NW

330 Ft. From N Line NW330 Ft. From E Line Quarter1st. Report AUG 1 1951

Completion

Remarks Deep Rock farmoutSpudding Date 7-30-51Drlg. Data Wilcoat8" @ 144 WOC

J. E. LYRA

Map No. _____ Sec. 6 Twp. 10 R. 21WWell No. 1 Beecher

_____ Barnett Drlg. _____ Company

_____ **CORRECTION** _____ Contractor

NW NW NE

SECTION PLAT

330 Ft. from N. Line

_____ Ft. from S. Line

_____ Ft. from E. Line

330 Ft. from W. Line

		0	

Graham County

Location _____

Rig up _____

Drilling and Remarks:

Reported

#1 Beetcher

NE NE NW

RECORD

Cased _____ in., _____ ft.

Sand _____

Gas _____

Oil _____

Total Depth _____

PRODUCTION

1st 24 hrs. Nat. _____

1st 24 hrs. after shot _____

Gas _____ Cu. Ft.

Dry Hole _____

Abandoned _____

Date

AUG 1 1951

19

J. E. TVF Scout

County Graham State Kansas
 Sec. 6 (Blk.) 10 (Sur.) 21W Map No.
 Operator Barnett Drlg.
 Well No. 1 Farm Beetcher
 Elev. 2301 Location NW NW NE

330 Ft. From N Line NE
 330 Ft. From W Line Quarter

1st. Report

Completion SEP 19 1951

Remarks Wildcat

Spudding Date 7-30-51

Drlg. Data Oil well TD 3882
8" @ 144 Anhy 1770 Heeb. 3486
KC 3525 DST 3549-76 open 1 hr.
Rec. 780' sw DST 3592-3620 open 1 hr.
Rec. 480' gas 125' ocm 120' whocm
B KC 3754 Simp. 3865 Arb. 3880-82
5" @ 3881 TD 3882 FU 2147' oil 6 hr.
Comp. 195 bopd

J. E. TYRA