


Graham

KANSAS

SECTION 6 TOWNSHIP 10S RANGE 22W

WELL NO. #1 E.G. Sandlin

COMPANY Skelly Oil Co.

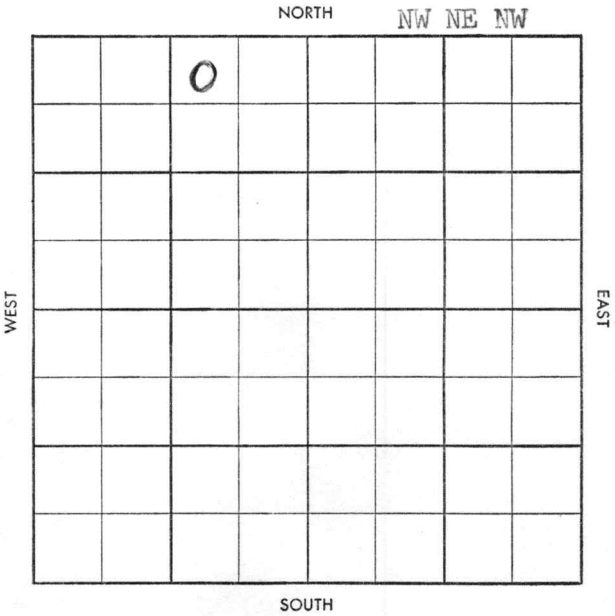

~~Redline~~

County Graham Elev. _____

Sec. 6 Twp. 10 Rge. 22W

Company Skelly Oil Co.

Farm Name E. G. Sandlin No. 1

TOPS	DEPTH	LOG	DATUM
Anh.			
Tp.			
H.			
Tr.			
Dg.			
B.L.			
L.			
K.C.			
B.K.C.			
Ce.			
C.			
M.			
M.			
K.			
Mz.			
Mq.			
V.			
S.			
S.			
A.			
R.			
Pf.			
G.			
T.D.			

Loc. in Sec. _____

NW NE NW

Geol. _____

Contr. _____

Pool _____

Vesper



Date Comm. _____

Location. 3900' BKC test.

Co. _____

Loc. _____

No. _____

Sec. _____

T. _____

R. _____

Twp. X Pool
 Co. Facet X

S-513-B

County Graham Elev. 2572.01 2395.98
 Sec. 6 Twp. 10 Rge. 22W
 Company Skelly Oil Co.
 Farm Name E. G. Sandlin No. 1

TOPS	DEPTH	LOG	DATUM
Anh.			
Tp.	3393		
H.	3614		
Tr.	3636		
Dg.			
B.L.			
L.	3653		
K.C.			
B.K.C.	3876		
Ce. <u>mark</u>	3935		
C.	4055		
M.			
M.			
K.			
Mz.			
Mq.			
V.			
S.			
S.			
A.			
R.			
Pf.			
G.			
T.D.	4134		

Loc. in Sec. NW NE NW
 Geol.
 Contr.
 Pool Vesper

0
APR 30 '58

ABANDONED

Date Comm. 4-14-58
 Location. 3900' BKC test. FEB 26 '58 MAR 5 '58

MAR 12 '58 MAR 19 '58 MAR 26 '58 APR 2 '58 APR 9 '58
APR 16 '58 APR 23 '58 8" 276/150 @ 3530
APR 30 '58 DST 3760-3835 @ 60" 100'
MSW BHP1080 DST(SD) 3594-3760
@ 1hr 1674's w BHP1220. DST
3835-3900 1hr 12'M VSSO NO PRESS

DBA

C. No. Sec. T. R.