


Graham

SECTION 6 TOWNSHIP 10 S RANGE 23 W

WELL NO. # 1 Gano

COMPANY D. G. Hansen

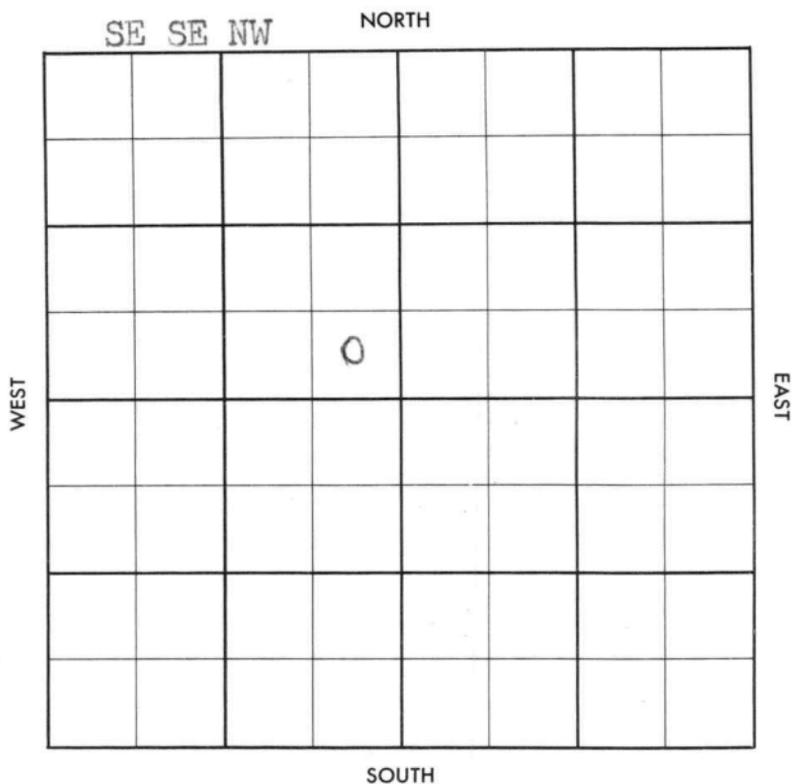

SEC. 6 TWP. 10 S R. 23 W

WELL NO. # 1 Gano FARM

COMPANY D. G. Hansen


CONTRACTOR Cook & Galloway Hoof

_____ FT. FROM N. LINE

_____ FT. FROM S. LINE

_____ FT. FROM E. LINE

_____ FT. FROM W. LINE

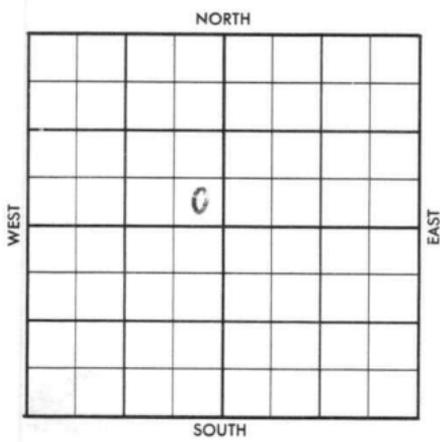

SE SE NW

SDX-1/2 Mile

ELEVATION

REPORT

1957

8/28

Comm. 8-23-57
8" @ 203
Drlg. 3060'

(DR Tkt)

1381 02 HUA
.M.M

FORM 513 SUNRAY

County Graham

Elev.

Sec. 6

Twp. 10

Rge. 23W

Company D. G. Hansen

Farm Name Gano

No. 1

Co.

Loc.

No.

Sec.

T.

R.

TOPS	DEPTH	LOG	DATUM
Anh.			
Tp.			
H.			
Tr.			
Dg.			
Bl.			
L.			
K.C.			
B.K.C.			
Ce.			
C.			
M.			
M.			
K.			
Mz.			
Me.			
V.			
S.			
S.			
A.			
R.			
Pe.			
G.			
T.D.			

Loc. in Sec.

SE SE NW

Geol.

Contr.

Cook & Galloway
tools

Pool

Hoof

FIRST	REPORT
<u>1/2 mile</u>	
AUG 28 '57	

SDX-

Date Comm. 8/23/57

8" @ 203, Drlg 3060

[Large handwritten signature/initials across the bottom section]

Co.

County Graham

Elev.

Sec. 6

Twp.

10

Rge.

23W

Company D. G. Hansen

Farm Name Gano

No. 1

	DEPTH	LOG	DATUM
Sp.	3334		
H.	3760		
Tr.	3781		
Dg.			
BL.			
L.	3797		
K.C.			
B.K.C.	4031		
Ce.			
C.			
M.			
M.			
K.			
Mz.			
Mq.			
V.			
S.			
S.			
A.			
R.			
PE.			
G.			
TD.	4043		

Loc. in Sec.

SE SE NW

Geol.

Contr.

Cook & Galloway

tools

Pool

Hoof

ABANDONED

1/2 MILE
SEP 4 '57

1/2

No.

Sec.

T.

R.

Date Comm. 8/23/57

8" @ 203, Drlg 3060 SEP 4 '57 DST 3820-45

1hr 75' OCM BHP 1020 DST

3917-50 30" 35' Md BHP 112

DST 3944-67 1 1/4 hrs 62' 50CM

BHP 1178 DST 3964-85 1hr

45' Md BHP 228

DCA