


SECTION 6 TOWNSHIP 10S RANGE 23W

WELL NO. #1 Johnson "C"

COMPANY Francis Oil & Gas & Kaiser

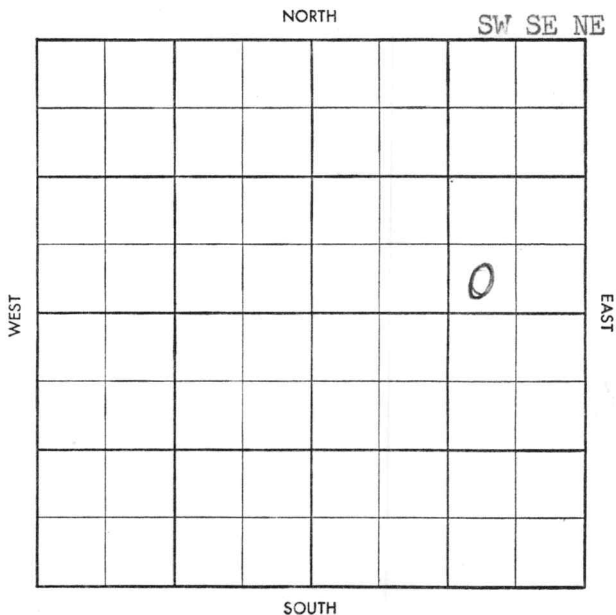

Top N Post N

Co. X Facet 5

S-513-B

County Graham Elev. \_\_\_\_\_  
 Sec. 6 Twp. 10 Rge. 23W  
 Company Francis Oil and Gas and Kaiser  
 Farm Name Johnson "C" No. 1

TOPS	DEPTH	LOG	DATUM
Anh.			
Tp.			
H.			
Tr.			
Dg.			
B.L.			
L.			
K.C.			
B.K.C.			
Ce.			
C.			
M.			
M.			
K.			
Mz.			
Mq.			
V.			
S.			
S.			
A.			
R.			
Pf.			
G.			
T.D.			

Loc. in Sec. \_\_\_\_\_  
SW SE NE  
4000' test  
 Geol. \_\_\_\_\_  
 Contr. \_\_\_\_\_  
 Pool \_\_\_\_\_  
Hoof NW

**FIRST REPORT**  
 MAR 19 58  
1/2 mile

SDX

Date Comm. \_\_\_\_\_ (Magnolia - FO)  
 Location \_\_\_\_\_

Co.  
 Lse.  
 No.  
 Sec.  
 T.  
 R.

Twp.            Pool             
 Co.            Facet           

S-513-B

County Graham Elev. 3110' 3155'  
 Sec 6 Twp 10 Rge. 23W

Francis Oil and Gas and Kaiser  
Johnson "C" No. 1

	LOG	DATUM
Anh.	2021	
Tp.		
H.	3721	
Tr.	3743	
Dg.		
B.L.		
L.	3757	
K.C.		
B.K.C.		
Ce.		
C.		
M.		
M.		
K.		
Mz.		
Mq.		
V.		
S.		
S.		
A.		
R.		
Pf.		
G.		
T.D.	4040	

Loc. in Sec. SW SE NE  
4000' test  
 Geol.             
 Cont. Armer  
 Pool Hoof NW  
**COMPLETE**  
1/2 mile  
 MAY 14 '58

Date Comm. 4-2-58 (Magnolia - FO)

Location MAY 26 '58 APR 2 '58 APR 9 '58 8" 195/  
APR 15 '58  
03204 DST 3726 - 85 gphr  
40' VSOCM BHP 660 DST 3779 - 3823  
14 hr 20' VSOCM BHP 870 DST 3868  
- 3922 7hr 60' MO 69cm 540 Hgx  
0 300 free oil DST 3819 - 73 2hrs  
660' gip 40' gem 60' 069cm 120' MO 360  
free oil 120' OCW 180' W ~~top~~ FP 75 - 390  
BHP 1090/20 DST (SP) 3812 - 45 DP 2hrs  
170' gem 120' OCW 180' MO 69cm 60' VMO

to gem FP150-225 BHP 1205/20"  
DST (SPEL) 3691-3722 op 1hr  
2540'W FP230-1030 BHP 1253h<sup>o</sup>

5 1/2 4038/200 no log woc APR 23 '58

APR 30 '58 CO 24/3910-16 \$ 3B0ph

max 3500A \$ 3080ph NT pop

MAY 7 '58 MAY 14 '58 Phyp 132B00d

4'0w gr 41.1

Lsg 3910-16