
DX 78-1

Sheridan

Section 7 Township 10 Range 26W KANSAS

Well No. #1 Kaiser

Company Heathman-Seeligson

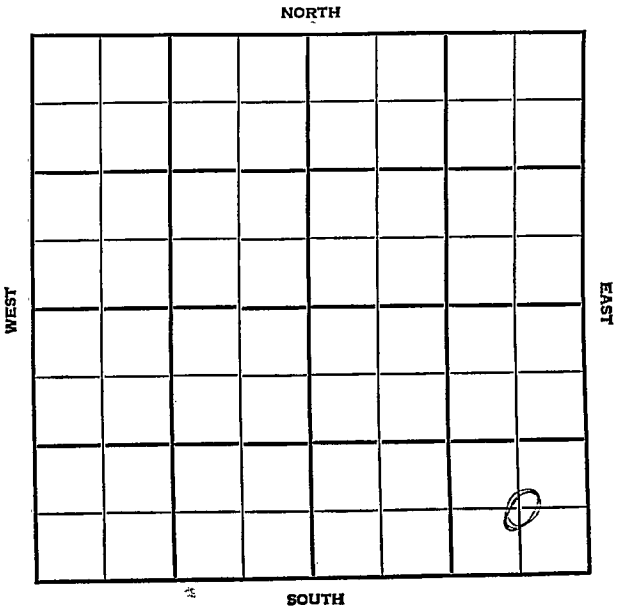

WILDCAT

FORM 513 SUNRAY

County Sheridan Elev.

Sec. 7 Twp. 10 Rge. 26W

Company Heathman-Seeligson

Farm Name Kaiser No. 1

TOPS	DEPTH	LOG	DATUM
Anh.	2280		
Tp.			
H.			
Tr.			
Dg.			
Bl.			
L.			
K.C.			
B.K.C.			
Ce.			
C.			
M.			
M.			
K.			
Mz.			
Mc.			
V.			
S.			
Si.			
A			
R.			
Pe.			
G.			
T.D.			

Loc. in Sec. C SE SE

Geol.

Contr. Co. tools

Pool Wildcat

FIRST REPORT DEC 5 56

Date Comm. 11-28-56

8⅝" @ 236/175 drlg. 3555

Co. Lse. No. Sec. T. R.

FORM 513 SUNRAY

County Sheridan Elev. 2647

Sec. 7 Twp. 10 Rge. 26W

Company Heathman-Seeligson

Farm Name Kaiser No. 1

TOPS	DEPTH	LOG	DATUM
Anh.	2280		
Tp.			
H.	3855		
Tr.		3877	
Dg.			
BL.			
L.	3896	3895	
K.C. Marm		4164	
B.K.C.			
Ce.			
C.			
M.	4451	4451	
M.			
K.			
Mz.			
Mo.			
V.			
S.			
S.			
A			
R.			
P€.			
G.			
TD	4513		

Loc. in Sec. C SE SE

Geol.

Contr. Co. tools

Pool Wildcat

ABANDONED

DEC 13 '56

Date Comm. 11-28-56 shell DHM

8" @ 236/175 drlg. 3555 DEC 12 '56

DST 3915-31 1hr 3'oil 17'OCM BHP 345/20" DST 3937-62 1hr 41' VSOCSW BHP 448/20

D&A