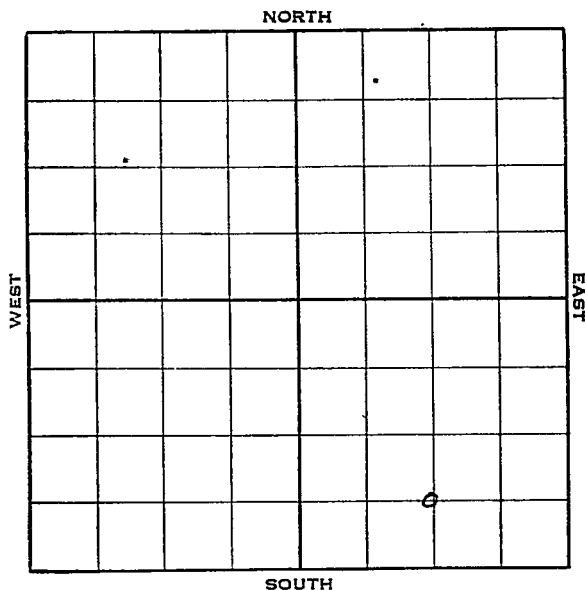
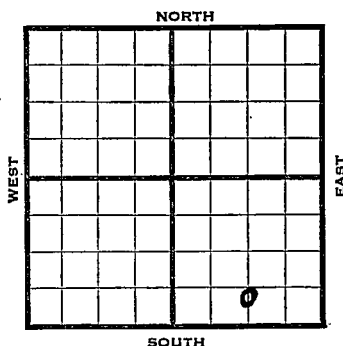


Ottawa

KANSAS

Section 7 Township 10 Range 2-WWell No. 1 CopemanCompany Babcock Oil

Sec. 7 Twp. 10 R. 2-WWell No. #1 Copeman FarmBabcock Oil Company Ft. from N. Line550 Ft. from S. Line1320 Ft. from E. Line Ft. from W. Line

Elev. 1367

1938	REPORT
6/15	20" at 186'. Drlg. 248'.
6/24	" " " " "
7/1	T. D. 340' C.O.
7/8	TD 432' fsg.
7/15	15" - 432'. Dlg. 720'.
7/22	Dlg. 1195'.
7/29	H.F.W. 1718'. C. O.
8/5	Base Florence 806'.
	Wreford 874'. Neva 1067'.
	T. D. 1718'. Cleaning out.
8/12	10" - 1765'. Dlg. 1965'.
8/19	T. D. 2050'. U. R. "10".
8/26	10" - 2094'. Dlg. 2110'.
9/2	10" - 2182'. S. D. 2220' repairs
9/9	T. D. 2330'.
9/16	SD 2600'.
9/23	" "
9/30	10" - 2332'. H.F.W. 2425-27'.
	Rng. 8".
10/7	" "
10/14	8" - 2549'. Dlg. 2562'.

OVER

1938

10/21 TD 2675' Fsg.

10/28 " " "

11/4 " " "

11/12 Chat. 2670'. 8" - 2671'.
Drlg. 2682'.

11/18 8" - 2709'. Dlg. 2775'.

11/25 8" - 2725'. Miss. 2840' ??
T. D. 2842'. C. O.

12/2 8" - 2820'. T. D. 2842'. C. O.

12/9 H.F.W. 2850-70'. 8" - 2887'.
H.F.W. 2915'. T.D. 2930'.
U. R. 8".

12/15 T. D. 3040'. SD repairs. 1367

12/23 H.F.W. 2970-90'. T.D. 3125'.
U. R. 8".

12/30 8" - 3125'.
Drlg. 3155'.

1939

1/6 8" - 3250'. Drlg. 3251'.

1/13 Hunton 3250'. H.F.W. 3302-10'.
C. O.

1/20 T. D. 3480'. SD for 6".

1/27 " " " " "

2/3 " " " " "

2/10 " " " " "

2/17 " " " " "

2/23 " " " " "

3/3 " " " " "

3/10 " " " " "

3/17 " " " " "

OVER

1939

3/24 TD 3480'
SD for 6".

3/31 " "

4/7 " "

4/14 " "

4/21 " "

4/28 " "

5/5 Run 7" = 3480'

5/12 7" - 3505' Drlg. 3617'

5/19 Viola 3505' Simp. 3631'
Wilcox ~~3675~~³⁶⁹² T.D. 3690'
U.R. 7".

5/26 " " "

6/1 Wilcox 3692' (Corrected)

6/8 Arb. 3744 - Drlg. 4065'

1367

6/14 Wilcox 3692'
7" - 3673'
Arb. 3744'
Granite wash 4008'
T.D. 4135'

ABANDONED

Ottawa

KANSAS

Map No. 60 Sec. 7 Twp. 10 R. 2WWell No. 1 CopemanBabcock Oil Company

Contractor

FIRST REPORT

Approx.

C S $\frac{1}{2}$ SE

Ft. from N. Line

550 Ft. from S. Line1320 Ft. from E. Line

Ft. from W. Line

SECTION PLAT

Location _____

Rig up _____

Drilling and Remarks:

20" - 186

Dr1g. 248

RECORD

Cased _____ in., _____ ft.

Sand _____

Gas _____

Oil _____

Total Depth _____

PRODUCTION

1st 24 hrs. Nat. _____

1st 24-hrs. after shot _____

Gas _____ Cu. Ft.

Dry Hole _____

Abandoned _____

Date

JUN 15 1938

19

H. D. Hatfield Scout

Map No. 60 Sec. 7 Twp. 10 R. 2WWell No. 1 CopemanBabcock Oil

Company

Contractor

ABANDONED

Approx. C S $\frac{1}{2}$ SE

SECTION PLAT

 Ft. from N. Line550 Ft. from S. Line1320 Ft. from E. Line Ft. from W. Line

WILDCAT

Location Rig up

Drilling and Remarks:

*Wilcox 3692**7" C 3673**Cox 3744**Granite Wash 4008*

RECORD

Cased in., ft.Sand Gas Oil Total Depth 4135

PRODUCTION

1st 24 hrs. Nat. 1st 24 hrs. after shot Gas Cu. Ft.Dry Hole Abandoned

Date

JUN 14 1939

19

S. J. LEWIS

Scout