


Section 7 Township 10 Range 15W

Well No. #1 Pfortmiller

Company Lindas Oil

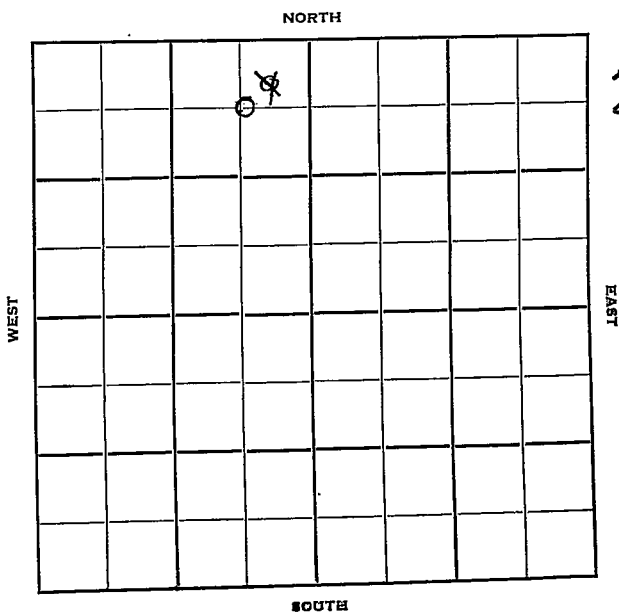

Osborne

KANSAS

Sec. 7 Twp. 10 R. 15 W

Well No. # 1 Pfortmiller Farm

Lindas Oil Company

Lindas Oil Contractor

660
330 Wildcat
Ft. from N. Line

Ft. from S. Line


660
330 Ft. from E. Line

Ft. from W. Line

C NE NW

~~NE NE NW~~

Amerada DHM

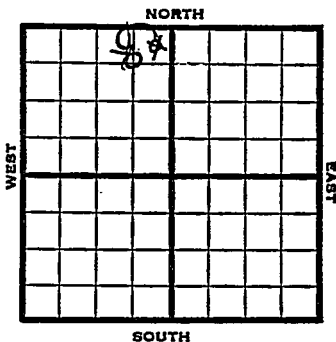

1951

Elev. 1942'

REPORT

8/8

8" @ 193
Drlg. 875'

8/22

SD& A TD 3610' 8" @ 193
Heeb 3101' KC 3145'
DST 3124-72 open 1/2 hr. rec 6' mud &
SSO
DST 3491-3515' open 20 min. rec 6' mud
Cong. 3515' TD 3610' D & A
ABANDONED

Map No. _____ Sec. 7 Twp. 10 R. 15W

Well No. 1 Pfortmiller

Lindas Oil Company

Contractor

C NE NW

SECTION PLAT

	0		
CORRECTION			

660 Ft. from N. Line

_____ Ft. from S. Line

660 Ft. from E. Line

_____ Ft. from W. Line

Osborne County

Location _____

Rig up _____

Drilling and Remarks:

Reported

NE NE NW

RECORD

Cased _____ in., _____ ft.

Sand _____

Gas _____

Oil _____

Total Depth _____

PRODUCTION

1st 24 hrs. Nat. _____

1st 24 hrs. after shot _____

Gas _____ Cu. Ft.

Dry Hole _____

Abandoned _____

Date

AUG 8 1959 19

J. E. TYRA Scout

