

Rooks

KANSAS

SECTION 7 TOWNSHIP 10 RANGE 17W

WELL NO. #1 Ross

COMPANY Iron Drlg.

NORTH

WEST

EAST

	0						

SOUTH

SEC. 7	TWP. 10	R. 17W
-----------	------------	-----------

WELL NO.

#1 Ross

FARM

COMPANY

Iron Drlg.

CONTRACTOR

Co. Tools


WILDCAT

_____ Ft. from N. Line

_____ Ft. from S. Line

_____ Ft. from E. Line

_____ Ft. from W. Line

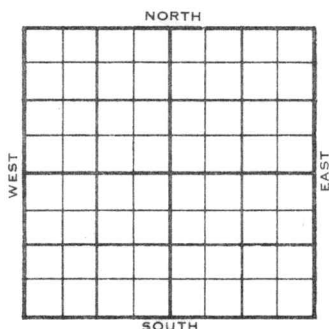

SE SW NW

	ELEVATION	REPORT
1956	2105'	
5-23	Comm. 5-18-56 8" @ 165 w/120 Drlg. 2360 Anh. 1415'	
6-6	DST 3460-3500 op 90 min. rec. 130' HOCM / 30' VHOCM, BHP 990/20" RTD 3680 D & A Tp. 3051', L. 3312', C. 3545', S. 3611 A. 3665' TD 3680'	

ABANDONED

County Rooks Elev. _____
 Sec. 7 Twp. 10 Rge. 17W
 Company Iron Drlg.
 Farm Name Ross No. 1

TOPS

DEPTH

LOG

DATUM

Loc. in Sec.

Anh.

1415SE SW NW

Tp.

H.

Tr.

Dg.

Bl.

L.

K.C.

B.K.C.

Ce.

C.

M.

M.

K.

Mz.

Me.

V.

S.

S.

A.

R.

P.C.

G.

T.D.

Geol.

Contr.

Co. tools

Pool

Wildcat

FIRST REPORT

MAY 23 '58

Date Comm. 5-18-56
8" @ 165/120 drlg. 2360

MAY 23 1958

R.G.

County Rooks Elev. 2105 Co.
 Sec. 7 Twp. 10 Rge. 17W
 Company Iron Drls.
 Farm Name Ross No. 1

TOPS	DEPTH	LOG	DATUM	Loc. in Sec.
Anh.	1115			SE SW NW
Tp.	3051			
H.				
Tr.				
Dg.				
Bl.				
L.	3312			Geol.
K.C.				Contr.
B.K.C.				Co. tools
Ce.	3545			Pool
C.				Wildcat
M.				
M.				
K.				
Mz.				
Mq.				
V.				
S.	3611			
S.				
A.	3665			
R.				
PE.				
G.				
TD.	3680			

Date Comm. 5-18-56 JUN 6 1956

8" @ 165/120 drlg. 2360 MAY 29 '56

DST 3460-3500 90" sec 130'

HOCM + 30' V HOCM BHP 990/20

IP 3610 JUN 6 '56 PTD 3680 Log

D&A