


Section 7 Township 10 Range 18 WWell No. #1 WiseCompany Nadel & Gussman

NORTH

WEST

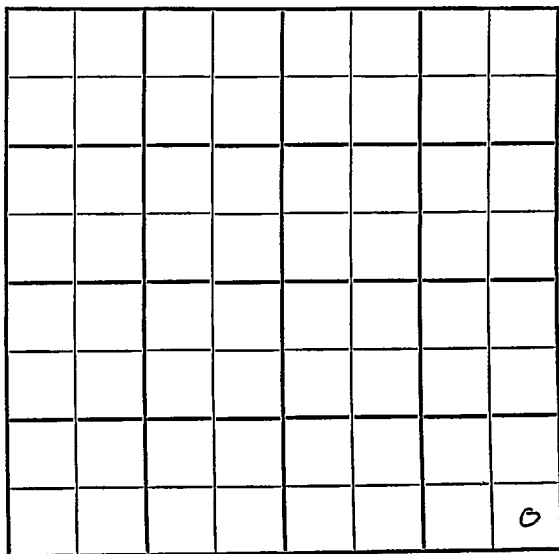

EAST

SOUTH

Rooks

KANSAS

SEC.	TWP.	R..
7	10	18W

WELL NO.

#1 Wise

FARM

COMPANY

Nadel & Gussman

CONTRACTOR

Reserve

Wildcat


_____ Ft. from N. Line

_____ Ft. from S. Line

_____ Ft. from E. Line

_____ Ft. from W. Line

SE SE SE

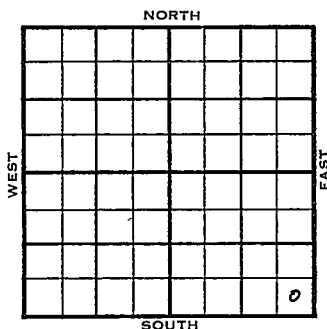

1955

ELEVATION

2187'

REPORT

10/12

Comm 10-10-55

8" @ 168/125

Drlg 1035

10/26

Comm 10-10-55

H

3396

L

3438

BKC

3646

C

3702

TD

3790

8" @ 165/125 DST 3497-3515 open 1/2

hr Rec 5' mud 0/20" DST 3597-3619

open 1 hr Rec 12' mud 670#

D & A

ABANDONED

County Rooks Elev. 10
 Sec. 7 Twp. 10 Rge. 18W
 Company Nadel & Gussman
 FarmName Wise No. 1

Co.

Lse.

No.

Sec.

T.

R.

TOPS	DEPTH	LOG	DATUM	Loc. in Sec.
Anh.				SE SE SE
Tr.				
H.				
Tr.				
Dg.				
Bl.				
L.				
K.C.				Geol.
B.K.C.				Contr.
Ce.				Reserve
C.				
M.				Pool
M.				Wildcat
K.				
Mz.				
Mo.				
V.				
S.				
S.				
A.				
R.				
Pe.				
G.				
T.D.				

FIRST REPORT
 OCT 12 35

Date Comm. 10-10-55
8" @ 168/125 drlg. 1035

County Rooks Elev. 2187
 Sec. 7 Twp. 10 Rge. 18W
 Company Nadel & Gussman
 Farm Name Wise No. 1

TOPS	DEPTH	LOG	DATUM	Loc. in Sec.
Anh.				SE SE SE
Tp.				
H.	<u>3396</u>		<u>1209</u>	
Tr.				
Dg.				
BL.				
L.	<u>3438</u>		<u>1251</u>	Geol.
K.C.				Contr.
B.K.C.	<u>3646</u>		<u>1459</u>	
Ce.				Reserve
C.	<u>3702</u>		<u>1515</u>	
M.				Pool
M.				Wildcat
K.				
Mz.				
Me.				
V.				
S.				
S.				
A.				
R.				
Pe.				
G.				
T.D.	<u>3790</u>			

ABANDONED

Date Comm. 10-10-55 OCT 26 1955
 8" @ 168/125 DST 3497-3515 open $\frac{1}{2}$ hr.
 Rec. 5' mud 0/20" DST 3597-3619
 open $\frac{1}{2}$ hr. rec. 12' mud 670#

D & A