

Well No. 2 Dick

Company Sohio et al

Berland
NORTH

[illegible]

Sec. 7 Twp. 10 R. 19W

Well No. #2. Dick Farm

Sohio et al

Company

Berland Pool (Rine Drlg., Cont.)


 Ft. from N. Line

330' Ft. from S. Line

330' Ft. from E. Line

 Ft. from W. Line

SE/C

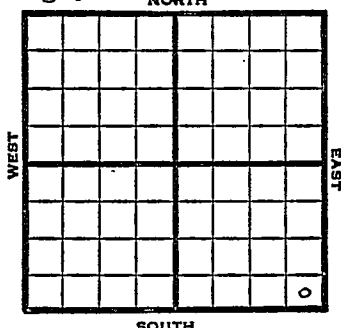

1949	Elev 2211'	REPORT
9/21	Location	
9/28	8" @ 1620'	
10/5	Drlg 3485'	
10/12	Lansing 3453'	
	Arb. 3767-73'	
	TD 3773'	
	5" @ 3768'	
10/19	1550' Oil 1½ hrs.	
10/26	"	
11/1	"	
11/9	"	
11/16	"	
11/23	"	
11/30	TD 3773'	
	Arb. 3767'	
	5" @ 3768'	
	Pump 501 Oil / 2% W Pot	
	29° Gr.	
	Comp	
	COMPLETED	

Map No. _____ Sec. 7 Twp. 10 R. 19W

Well No. 2 Dick

Sohio et al.


Company

Rine Drle.

Contractor

SE/c

FIRST REPORT
SECTION PLAT

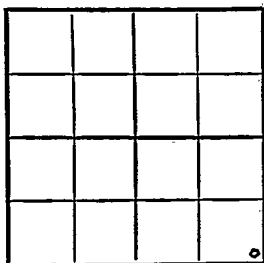

_____ Ft. from N. Line

330 _____ Ft. from S. Line

330 _____ Ft. from E. Line

_____ Ft. from W. Line

Rooks County

RECORD

Location X

Cased _____ in., _____ ft.

Rig up _____

Sand _____

Drilling and Remarks:

Gas _____

Oil _____

Total Depth _____

PRODUCTION

1st 24 hrs. Nat. _____

1st 24 hrs. after shot _____

Gas _____ Cu. Ft.

Dry Hole _____

Abandoned _____

Date

SEP 21 1949 19

S. J. LEWIS Scout

Map No. _____ Sec. 7 Twp. 10 R. 19W

Well No. 2 Dick

Sohio et al. Company

COMPLETE

Contractor

SE/C


E1,2211
SECTION PLAT

_____ Ft. from N. Line

330 Ft. from S. Line

330 Ft. from E. Line

_____ Ft. from W. Line

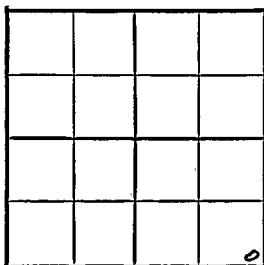

Rooks County

Location _____

Rig up _____

Drilling and Remarks:

*Cor 43767
5" Cor 43768*

*Prod 501 oil +
2 1/2 W.B.Y*

29-2-4

RECORD

Cased _____ in., _____ ft.

Sand _____

Gas _____

Oil _____

Total Depth 3723

PRODUCTION

1st 24 hrs. Nat. _____

1st 24 hrs. after shot _____

Gas _____ Cu. Ft.

Dry Hole _____

Abandoned _____

Date

NOV 30 1949 19 S. J. LEWIS Scout