


KANSAS Rocks

Section 7 Township 10 Range 19W

Well No. #4 Atherton

Company G & G Drlg.

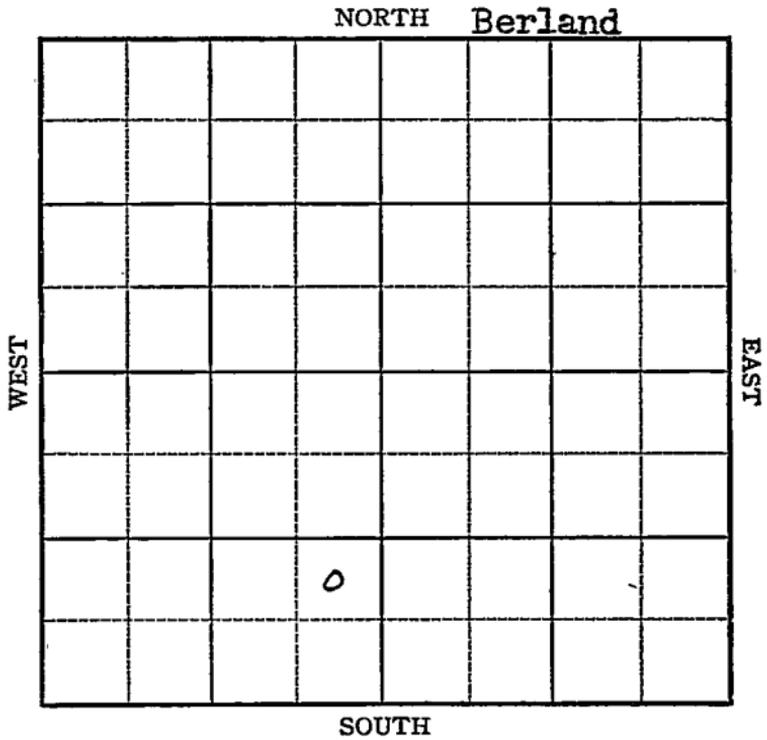

KANSAS

Rooks

Sec. 7 Twp. 10 R. 19W ✓

Well No. #4 Atherton Farm

C & G Drlg. Company


Berland Pool (C & G Drlg., Cont.)

_____ Ft. from N. Line

990' Ft. from S. Line

330' Ft. from E. Line

_____ Ft. from W. Line

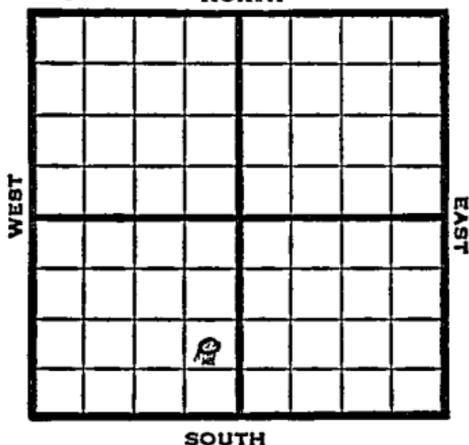

NE SE SW

SOUTH

1949

Elev. 2233' REPORT

- 9/14 8" @ 260'
Anhy 1654'
Drlg. 2400'
- 9/21 Lansing 3480'
Drlg. 3531'
- 9/28 Arbuckle 3782
5" @ 3782
TD 3791
4000 acid
Swb 6 bbls oil PH
- 10/5 "
- 10/12 "
- 10/19 "
- 10/26 "
- 11/1 "
- 11/9 "
- 11/16 "
- 11/23 "
- 11/29 "
- 12/7 "
- 12/14 "
- 12/21 "
- 12/28 "

1950
1/25

8" @ 260' 5" @ 3782'
Anhy 1654' Arb 3782'
Heeb 3441' Lans 3480'
Simp 3783'
P 174 BOPD
TD 3783'

COMPLETED

Map No. _____ Sec. 7 Twp. 10 R. 19W

Well No. 4 Atherton

C & G Drlg. _____ Company

C & G Drlg. _____ Contractor

NE SE SW

SECTION PLAT

| | | | |
|--|--|--|--|
| | | | |
| | | | |
| | | | |
| | | | |

_____ Ft. from N. Line

990 Ft. from S. Line

330 Ft. from E. Line

_____ Ft. from W. Line

Rooks County

RECORD

Location _____

Rig up _____

Drilling and Remarks:

8" @ 260

Anhy 1654

drlg. 2400

Cased _____ in., _____ ft.

Sand _____

Gas _____

Oil _____

Total Depth _____

PRODUCTION

1st 24 hrs. Nat. _____

1st 24 hrs. after shot _____

Gas _____ Cu. Ft.

Dry Hole _____

Abandoned _____

Date

SEP 14 1949

19

S. J. LEWIS

Scout

Kansas

Map No. _____ Sec. 7 Twp. 10 R. 19W


Well No. 4 Atherton

C & G Drlg. Company

Contractor

NE SE SW

E1. 2233
SECTION PLAT

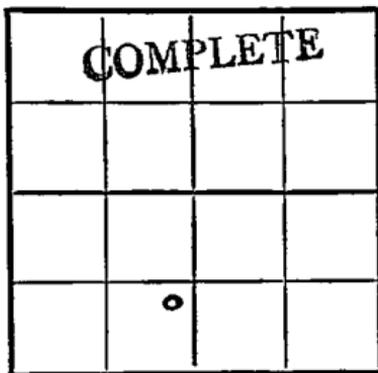

_____ Ft. from N. Line

990 Ft. from S. Line
C

330 Ft. from E. Line

_____ Ft. from W. Line

Rooks County

RECORD

Location _____

Cased _____ in., _____ ft.

Rig up _____

Sand _____

Drilling and Remarks:

Gas _____

Oil _____

8" @ 260
5" @ 378², art 378²

Total Depth 3783

ank 1654
Heb 3441
Lans. 3480
Sinp 3783
P 174 BOPD

PRODUCTION

1st 24 hrs. Nat. _____

1st 24 hrs. after shot _____

Gas _____ Cu. Ft.

Dry Hole _____

Abandoned _____

Date

JAN 25 1950

19

J. E. TYRA Scout