


Section 7 Township 10 Range 19-W

Well No. #6 Dick

Company Sohio & Rine

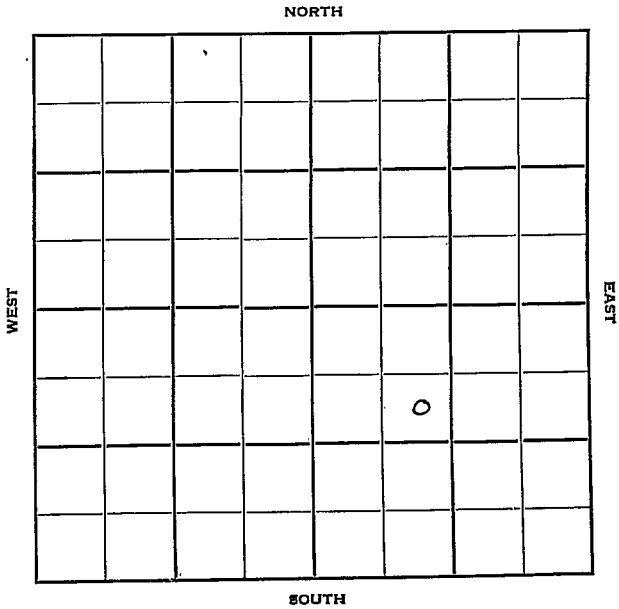

Sec. 7 Twp. 10 R. 19W

Well No. #6 Dick Farm

Sohio & Rine Company

Contractor

Berland Pool


990' Ft. from N. Line

_____ Ft. from S. Line

_____ Ft. from E. Line

990' Ft. from W. Line

SE NW SE

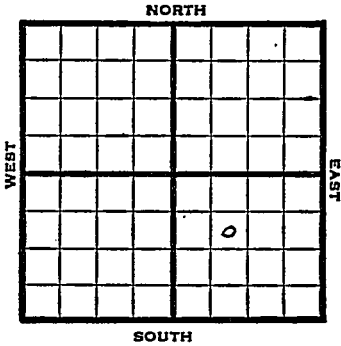

1950	Elev 2214 REPORT
6/28	Spud 6-21-50 Anhy 1622' 8" @ 1632' Drlg. 3450'
8/2	Anhy 1622 8" @ 1632 Lans 3476 DST 3617-53 opn 40 min rec 5' mud DST 3646-85, opn 40 min rec 25' mud Arb 3789 TD 3790 5" @ 3790 B/1½ gf 30 min 500A Comp 117 bopd Completed COMPLETED

Map No. _____ Sec. 7 Twp. 10 R. 19WWell No. 6 DickSohio & Rine

Company

Contractor

SE NW SE

SECTION PLAT

990 Ft. from N. Line

_____ Ft. from S. Line

_____ Ft. from E. Line

990 Ft. from W. Line

FIRST REPORT

Rooks County

Location _____

Rig up _____

Drilling and Remarks:

Spud 6-21-50

Anhy 1622

8" @ 1632

drlg. 3450

RECORD

Cased _____ in., _____ ft.

Sand _____

Gas _____

Oil _____

Total Depth _____

PRODUCTION

1st 24 hrs. Nat. _____

1st 24 hrs. after shot _____

Gas _____ Cu. Ft.

Dry Hole _____

Abandoned _____

Date

JUN 28 1950 19J. E. TYRA Scout

