


Section 7 Township 10 Range 19-W

Well No. #1 Dunlap

Company C & G Drlg.

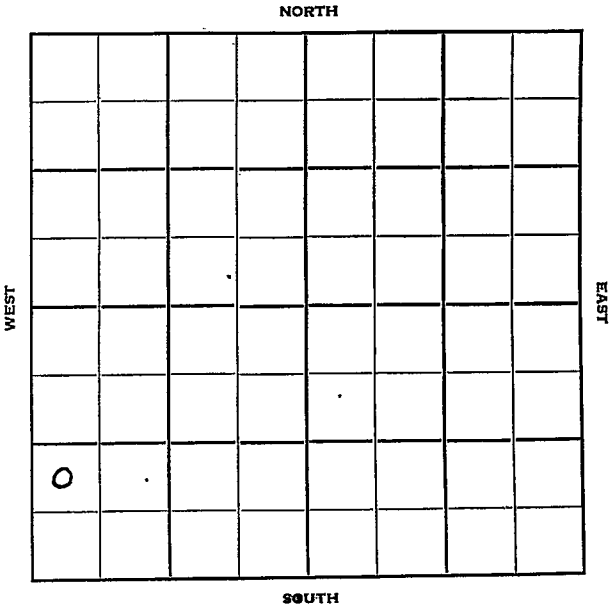

Rooks KANSAS

Sec. 7 Twp. 10 R. 19W

Well No. #4 Dunlap Farm

G & G Drlg. Company

G & G Drlg. - Contr. Contractor

Beiland Pool


 Ft. from N. Line

990' Ft. from S. Line

 Ft. from E. Line

330' Ft. from W. Line

NW SW SW

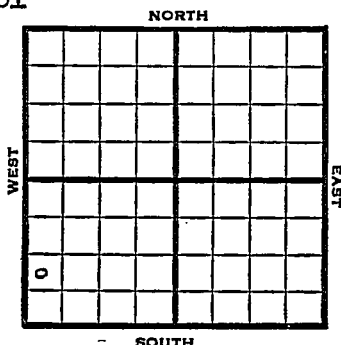

1950

Elev 2227'

REPORT

11/15

Location

12/27

Spud 11-19-50

8" @ 250

Anhy 1636

Tpp 3229

Heeb 3440

Toronto 3459

Lans 3479

Cong 3714

Simp 3761

Arb 3775-81

5" @ 3776

TD 3781

S/6 bopd

1000 A

S/15 boph

Comp 128 bopd

Completed

COMPLETED

J. E. TYRA

