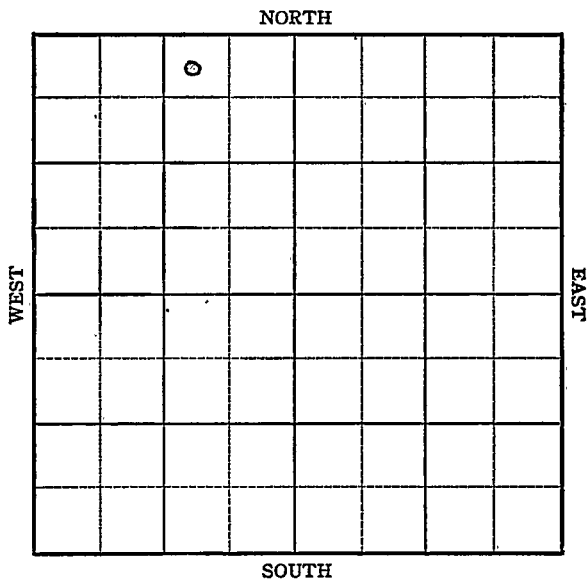


KANSASSection 7 Township 10 Range 19-WWell No. #6 OuderkirkCompany Nadel & Gussman
Berland Pool

KANSAS

Rooks ✓

Sec. 7 Twp. 10 R. 19W

Well No. 6 Ouderkirk Farm

Nadel & Gussman Company

Berland Pool Nadel & Gussman Contr.


330 Ft. from N. Line

 Ft. from S. Line

990 Ft. from E. Line

 Ft. from W. Line

NW NE NW

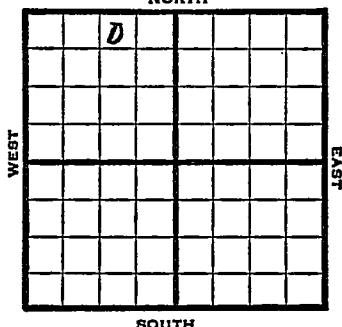

1949 Elev 2230' REPORT

8/24 Location
8/31 8" @ 160'
Drlg. 2700'
9/7 Lansing 3465'
Arbuckle 3752'
TD 3756'
5" @ 3752'
9/14 TD 3757'
Swb 42 bbls oil PH
500 acid
9/21 TD 3757'
Arb. 3752'
5" @ 3752'
500 acid
Depth Pot 3000 Oil
28⁷ Gr.
Comp

COMPLETED

Map No. _____ Sec. 7 Twp. 10 R. 19W

Well No. 6 Ouderkirk

Nadel & Gussman Company

Nadel & Gussman Contractor

NW NE NW

FIRST REPORT
SECTION PLAT

	0		

330 Ft. from N. Line

_____ Ft. from S. Line

990 Ft. from E. Line

_____ Ft. from W. Line

Rooks' County

Location X

Rig up _____

Drilling and Remarks:

RECORD

Cased _____ in., _____ ft.

Sand _____

Gas _____

Oil _____

Total Depth _____

PRODUCTION

1st 24 hrs. Nat. _____

1st 24 hrs. after shot _____

Gas _____ Cu. Ft.

Dry Hole _____

Abandoned _____

Date

AUG 24 1949 19 S. J. LEWIS Scout

KADAM

Berland Pool

Map No. K45 Sec. 7 Twp. 10 R. 19WWell No. 6 Ouderkirk

Nadel & Gussman

Company

COMPLETE

Contractor

NW NE NW

E. 12230
SECTION PLAT330 Ft. from N. Line Ft. from S. Line990 Ft. from E. Line Ft. from W. Line

	o		

Rooks County

RECORD

Location Rig up

Drilling and Remarks:

Cased in., ft.Sand Gas Oil Total Depth 3757

PRODUCTION

1st 24 hrs. Nat. 1st 24 hrs. after shot Gas Cu. Ft.Dry Hole Abandoned

Date

SEP 21 1949 19

S. J. LEWIS

Scout