


Section 7 Township 10 Range 19 W

Well No. # 11 Ouderkirk

Company Nadel & Gussman

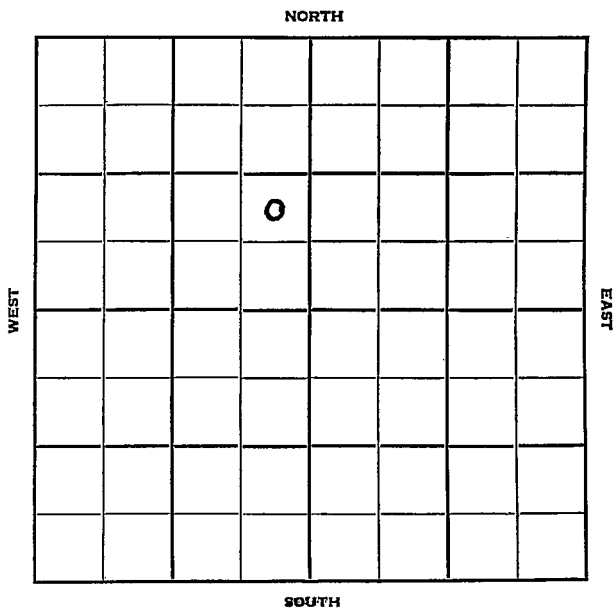

Sec. 7 Twp. 10 R. 19W

Well No. #11 Ouderkirk Farm

Nadel & Gussman Company

Reserve Drlg. Contractor

Marcotte Pool

_____ Ft. from N. Line


990 Ft. from S. Line

330 Ft. from E. Line

_____ Ft. from W. Line

NE SE NW

EL. 2227

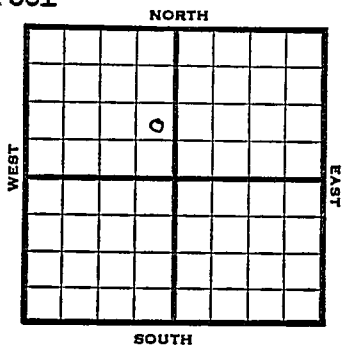

1952

REPORT

7/30 Spud 7-26-52
 8" @ 140'
 Anhy 1647'
 Drlg. 1808'

8/6 Heeb. 3428' Lans. 3487
 Drlg. 3655'

8/13 Spud 7-26-52
 D&A TD 3855
 8" @ 140'
 Anhy 1647 Heeb. 3438
 Lans. 3487 B KC 3699
 Cong. 3740 Simp. 3820
 Arb. 3834
 TD 3855 D&A

ABANDONED

