


Section 7 Township 10 Range 19W

Well No. #8 Ouderkirk

Company Nadel & Gussman

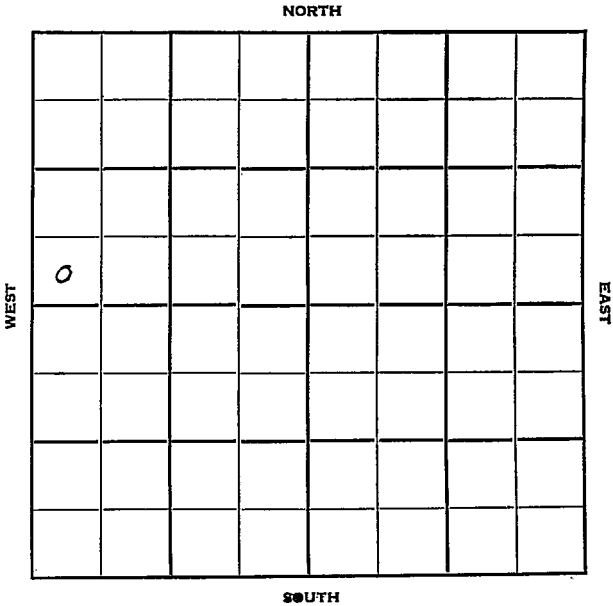

Rooks

KANSAS

Sec. 7 Twp. 10 R. 19 W

Well No. # 8 Ouderkirk Farm

Nadel & Gussman Company

Contractor

Berland Pool


Ft. from N. Line

330 Ft. from S. Line

Ft. from E. Line

330 Ft. from W. Line

SW SW NW

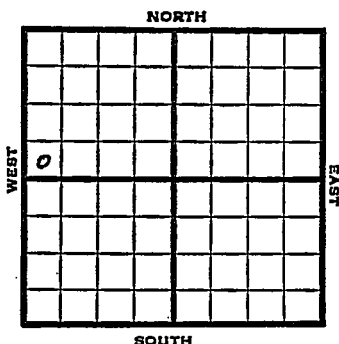

1951 Elev. 2230' REPORT

2/7 Location

4/11 Spud 2-9-51
Oil well TD 3807'
8" @ 160 Anhy 1648' Heeb 3443'
Toronto 3463', Lans 3480',
B KC 3699', Cong 3730' Simp 3786'
Arb. 3803'
TD 3807' 5" @ 3802 84/3791-3802
750 A S/5 BOPH SSO
Comp. 124 BOPD

COMPLETED

County Rooks State Kansas
 Sec. 7 (Blk. 10 (Sur. 19W Map No.
 (Twp.) (Rge.)
 Operator Nadel & Gussman
 Well No. 8 Farm Onderkirk
 Elev. Location SW SW NW

FIRST REPORT							
0							

330 Ft. From S Line NW

330 Ft. From W Line Quarter

1st. Report FEB 7 1951

Completion

Remarks

Spudding Date

Drlg. Data Berland Pool

Location

J. E. TYRA

County _____ Rocks _____ State KansasSec. 7 (Blk.
Twp.) 10 (Sur.
Rge.) 19W Map No. _____Operator Nadel & GussmanWell No. 8 Farm OuderkirkElev. 2230 Location SW SW NW

0							

330 Ft. From S Line NW330 Ft. From W Line Quarter

1st. Report _____

Completion APR 11 1951Remarks Berland PoolSpudding Date 2-9-51Drilg. Data Oil well TD 38078" @ 160 Anhy 1648 Heeb. 3443 ForToronto 3463 Lans. 3480 B KC 3699Cong. 3730 Simp. 3786 Arb. 3803TD 3807 5" @ 3802 84/ 3791-3802750 A S/ 5 boph SSO Comp. 124 bopd

J. E. TYRA