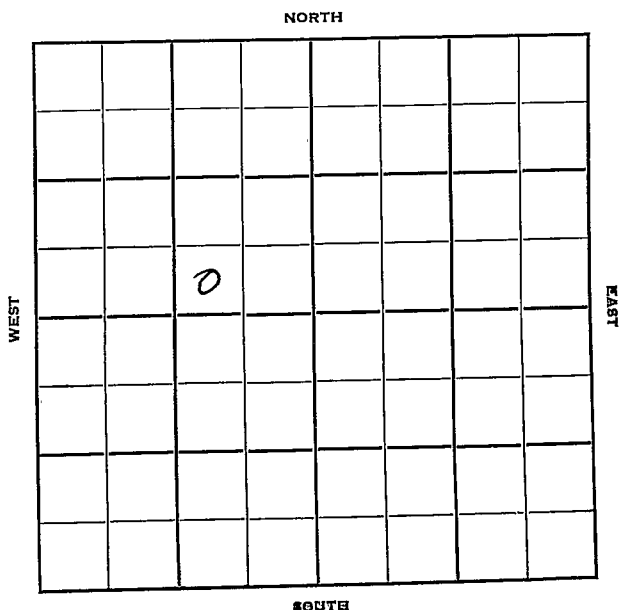


Section 7 Township 10 Range 19WWell No. #10 OuderkirkCompany Nadel & Gussman

Rooks

KANSAS

Sec. 7 Twp. 10 R. 19 W

Well No. # 10 Onderkirk Farm

Nadel & Gussman Company

Burland Contractor


 Ft. from N. Line

330 Ft. from S. Line

990 Ft. from E. Line

 Ft. from W. Line

SW SE NW

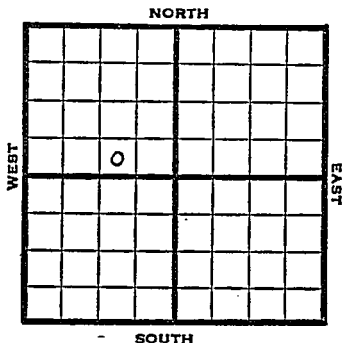

1951

Elev. 2221' REPORT

11/14

Location

1952

1/23

Spud 11-14-51

Oil well TD 3771' 10" @ 148

Anhy 1634' Heeb 3425' Tor. 3446'

Lans. 3464' Cong. 3704' Simp. 3758

Arb. 3764-67'

5" @ 3764 TD 3771 3000 A

S/10 BOPH 1 hr.

Comp. 413 BOPD 3% water.

COMPLETED

J. E. TYRA

County _____ Rocks _____ State Kansas
 Sec. 7 (Blk. 10) (Sur. 19W) Map No. _____
 Operator Nadel & Gussman
 Well No. 10 Farm Ouderkirk
 Elev. 2221 Location SW SE NW

330 Ft. From S Line NW
990 Ft. From E Line Quarter
 1st. Report _____
 Completion JAN 23 1952
 Remarks Berland Pool

Drilg. Data Oil well TD 3771
Spudding Date 11-14-51

10" @ 148 Anhy 1634 Heeb. 3425

Tor. 3446 Lans. 3464 Cong. 3704

Simp. 3758 Arb. 3764-67 5" @ 3764

TD 3771 3000 A \$/ 10 boph 4 hr.

Comp. 413 bopd 3% water

J. G. McGEHEE