

KANSAS


Rooks

Section 17 Township 10 Range 19WWell No. 1 VickCompany Sohio & Rine

Berland

NORTH

WEST

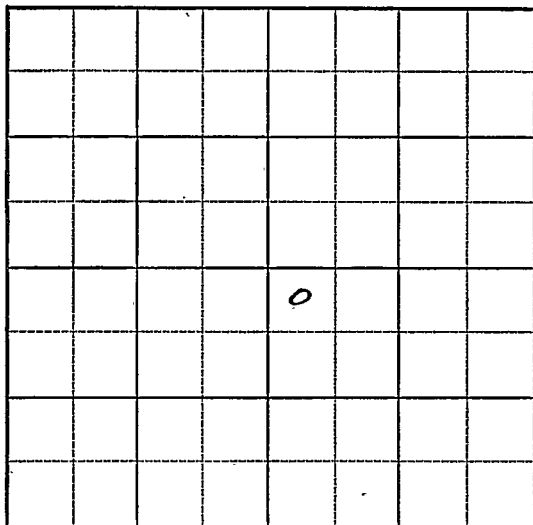

EAST

SOUTH

KANSAS

Rooks

Sec. 7 Twp. 10 R. 19W 

Well No. #1 Vick Farm

Sohio & Rine Company

Berland (Rine Drlg., Cont.)
Pool

NORTH


330' from N. Line

 Ft. from S. Line

 Ft. from E. Line

330' Ft. from W. Line

WEST

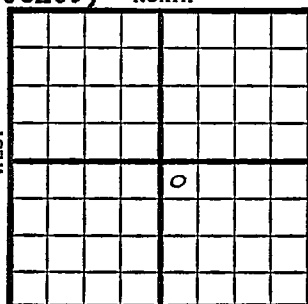

EAST

SOUTH

NW SE

1949

Elev 2211'

REPORT

6/1 Surface Hole

6/7 Drlg. 3020'

6/15 8"@ 1626'

Lansing 3459'

BKC 3669'

Simpson 3742'

Arb. 3762-66'

TD 3766'

5"@ 3763'

6/21 "

6/28 500 acid

Swb 10 bbls oil PH 6 hrs.

7/6 "

7/12 "

7/20 "

7/27 "

8/3 "

8/10 TD 3766'

Arb. 3762'

5"@ 3763'

500 acid

Pump 203 oil Pht

28° Gr.

Comp

COMPLETED

Map No. _____ Sec. 7 Twp. 10 R. 19W

Well No. 1 Vick

Sohio & Rine Company

Rine Drlg. Contractor

NW SE

FIRST REPORT
SECTION PLAT

330 Ft. from N. Line

_____ Ft. from S. Line

_____ Ft. from E. Line

330 Ft. from W. Line

		6	

Rooks County

Location _____

Rig up _____

Drilling and Remarks:

surface hole

RECORD

Cased _____ in., _____ ft.

Sand _____

Gas _____

Oil _____

Total Depth _____

PRODUCTION

1st 24 hrs. Nat. _____

1st 24 hrs. after shot _____

Gas _____ Cu. Ft.

Dry Hole _____

Abandoned _____

Date

JUN 1 1949 19

S. J. LEWIS Scout

Kansas

Map No. K65 Sec. 7 Twp. 10 R. 19WWell No. I Vick

Sohio & Rine

Company

COMPLETE


Contractor

NW SE

E1, 2211
SECTION PLAT330 Ft. from N. Line

Ft. from S. Line

Ft. from E. Line

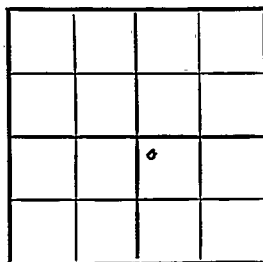330 Ft. from W. Line

Rooks County

RECORD

Location

Cased _____ in., _____ ft.

Rig up

Sand

Drilling and Remarks:

Gas

Oil

Total Depth 3766

PRODUCTION

1st 24 hrs. Nat. _____

1st 24 hrs. after shot _____

Gas _____ Cu. Ft.

Dry Hole

Abandoned

Oil # 37625" C 3763500 rodsPump 203 oil Prod28th

Date

AUG 10 1949

19

S. J. LEWIS

Scout