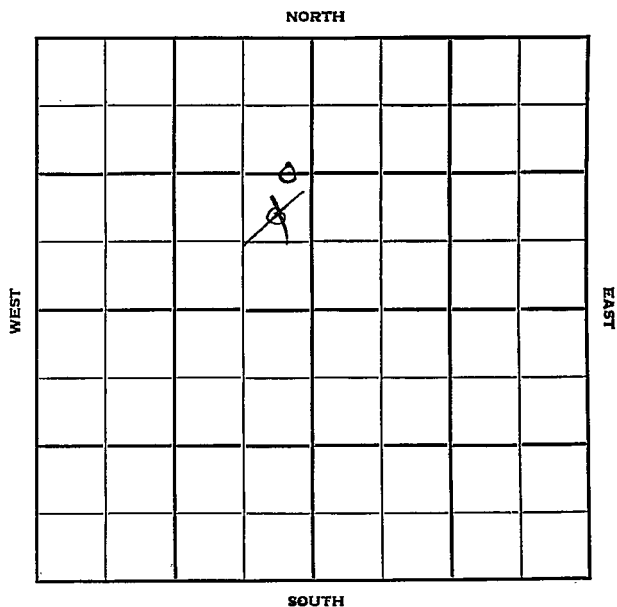


Section 7 Township 19 Range 20WWell No. #3 HolmesCompany Brooks Hall

Rooks
10

KANSAS

20W

Sec. 7 Twp. 10 R. 20W

Well No. #3 Holmes Farm

Brooks Hall

Company

Walters - Contr.

Contractor


Palco

1320 Ft. from N. Line

990 Ft. from S. Line

330 Ft. from E. Line

CEL E 1/2 NW
NE SE NW

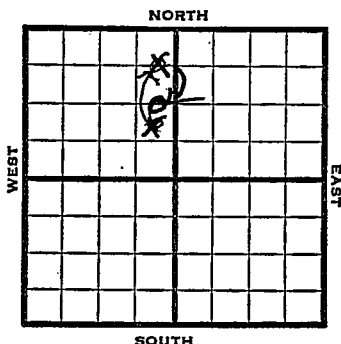

1952

Elev. 2264'

REPORT

2/6

Spud 2-3-52

8" @ 155

Drlg. 275

2/13

Anhy 1755 Topeka 3310

Heeb. 3516 Lans. 3555

Drlg. 377'

2/20

Spud 2-3-52

D & A TD 3890'


8" @ 155 Anhy 1755' Top 3310'

Heeb 3516' Tor. 3542' Lans. 3555'

Cong. 3850'

TD 3890' D & A

ABANDONED

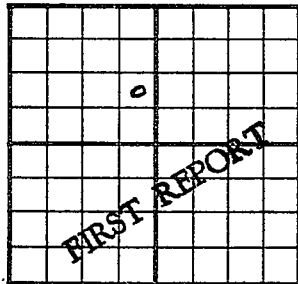County Rooks State KansasSec. 7 (Blk.) 10 (Sur.) 20W Map No.Operator Brooks HallWell No. 3 Farm HolmesElev. Location NE SE NW990 Ft. From S Line NW330 Ft. From E Line Quarter1st. Report FEB 6 1952

Completion

Remarks

Walters - Contr.Spudding Date 2-3-52Drlg. Data Paleo8" @ 155 Drlg. 275J. G. McGEHEE

Kansas

Map No. _____ Sec. 7 Twp. 10 R. 20WWell No. 3 HolmesBrooks Hall Company~~CORRECTION~~ ContractorC E L E $\frac{1}{2}$ NW

SECTION PLAT

_____ Ft. from N. Line

1320 Ft. from S. Line330 Ft. from E. Line

_____ Ft. from W. Line

	9		

Rooks County

Location _____

Rig up _____

Drilling and Remarks:

Reported

NE SE NW

RECORD

Cased _____ in., _____ ft.

Sand _____

Gas _____

Oil _____

Total Depth _____

PRODUCTION

1st 24 hrs. Nat. _____

1st 24 hrs. after shot _____

Gas _____ Cu. Ft.

Dry Hole _____

Abandoned _____

Date

FEB 13 1952

19

J. G. McGEHEE


Scout

County Rooks State Kansas
 Sec. 7 (Blk.) 10 (Sur.) 20W Map No.

Operator Brooks Hall

Well No. 3 Farm Holmes

Elev. 2264 Location CE 2 E/2
~~NE SE NW~~

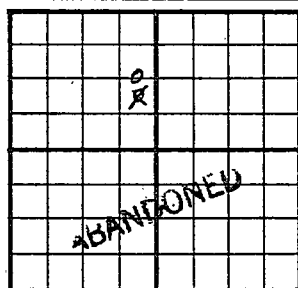

1320
~~990~~ Ft. From S Line NW

330 Ft. From E Line Quarter

1st. Report

Completion FEB 20 1952

Remarks Palco Pool

Walters Drlg. - Contr.

Spudding Date 2-3-52

Drlg. Data D & A TD 3890

8" @ 155 Anhy 1755 Top. 3310

Heeb. 3516 Tor. 3542 Lans. 3555

Cong. 3850 TD 3890

D & A

J. G. McGEHEE