

Rooks


FORM 51 25M 3-49 PETROL

KANSAS

Section 7 Township 10 Range 20W

Well No. #1 Sauer

Company Champlin, CRA & Holly

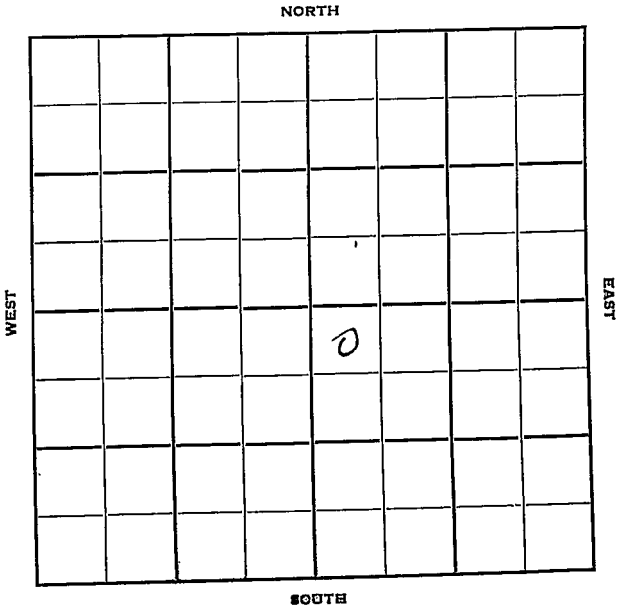

Rooks

KANSAS

Sec. 7 Twp. 10 R. 20W

Well No. #1 Sauer Farm

Champlin, CRA & Holly Company

Champlin Contractor

SW Palco Pool


330 Ft. from N. Line

_____ Ft. from S. Line

_____ Ft. from E. Line

330 Ft. from W. Line

NW NW SE

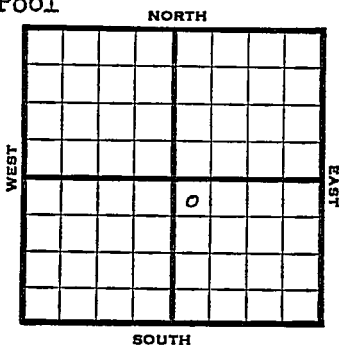

1951 Elev. 2247' REPORT

10/24 RUR

12/19 Spud 10-22-51
Oil Well TD 3861
8" @ 197
Anhy 1665 Heeb. 3498
Lans. 3534
DST 3615-47 open 1 hr. rec. 89'
mud & sw Arb. 3854
DST 3854-60 open 1 hr.
Rec. 15' mud 60' hvy. oil
5" @ 3855 TD 3861 B/ 6 GO & fresh
wtr. 2 hr. 20/ 3855-60
B/ 1½ goph 500 A S/ 24 BO
6 hr. Comp. 64 BOPD

COMPLETED

