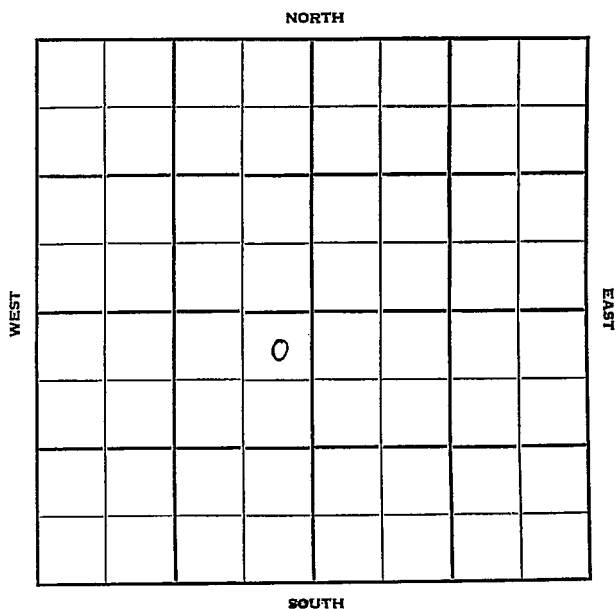


Section 7 Township 10 Range 20 WWell No. # 1 TempleCompany Republic Natural

Rooks

KANSAS^S

Sec. 7 Twp. 10 R. 20W

Well No. #1 Temple Farm

Republic Natural Company

Jones, Shelburn & Farmer Contractor

Palco


330 Ft. from N. Line

 Ft. from S. Line

330 Ft. from E. Line

 Ft. from W. Line

NE NESW

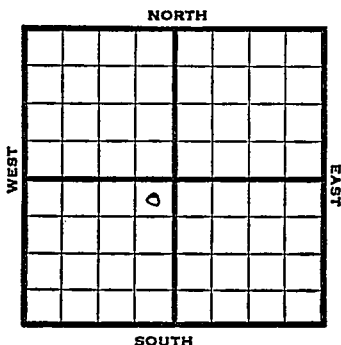

1951

Elev. 2264'

REPORT

11/7

Drlg.

12/12

Spud 11-5-51

Oil Well TD 3869

8" @ 155

Anhy 1745 Heeb. 3504

DST 3570-3650 open $\frac{1}{2}$ hr.

Rec. 825' SW

DST 3858-66 open $\frac{1}{2}$ hr. rec. 600' oil

Arb. 3859

5" @ 3859 TD 3866 CO to 3866

350 A S/ $4\frac{1}{2}$ BOPH 12 hr.

DD 3869 S/ $4\frac{1}{2}$ BOPH

Comp. 200 BOPD

COMPLETED

County _____ State KansasSec. 7 Reels (Blk.) 10 (Sur.) 20W Map No.Operator Republic NaturalWell No. 1 Farm TempleElev. _____ Location NE NE SW

FIRST REPORT									

330 Ft. From N Line SW330 Ft. From E Line QuarterIst. Report NOV 7 1951

Completion _____

Remarks _____


Jones, Shelburn & Farmer-Cont

Spudding Date _____

Drig. Data PalcoDrig.

J. E. TYRA

County _____ Rocks _____ State **Kansas**
 Sec. **7** (Blk.) **10** (Sur.) **20W** Map No. _____
 Operator **Republic Natural**
 Well No. **1** Farm **Temple**
 Elev. **2264** Location **NE NE SW**

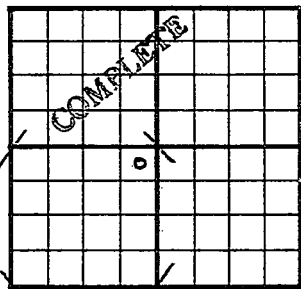

330 Ft. From **N** Line **SW**
330 Ft. From **E** Line **Quarter**
 1st. Report _____
 Completion **DEC 1 2 1951**
 Remarks **Palco Pool**
J-S-F - Contr.
 Spudding Date **11-5-51**

Drilg. Data **Oil well** **TD 3869**
8" @ 155 **Anhy 1745** **Heeb. 3504**
DST 3570-3650 **open $\frac{1}{2}$ hr.** **Rec. 825' sw**
DST 3858-66 **open $\frac{1}{2}$ hr.** **Rec. 600' oil**
Arb. 3859 **5" @ 3859** **TD 3866**
CO to 3866 **350 A** **S/ $4\frac{1}{2}$ boph** **12 hr.**
DD 3869 **S/ $4\frac{1}{2}$ boph** **Comp. 200 bopd**

J. E. TYRA