

Company Brooks Hall

WEST

EAST

SOUTH

Rooks

KANSAS

Sec. 7 Twp. 10 R. 20W

Well No. #2 Sauer Farm

Brooks Hall Company

JS&F Contractor


 Ft. from N. Line

330 Ft. from S. Line

 Ft. from E. Line

330 Ft. from W. Line

SW SW NE

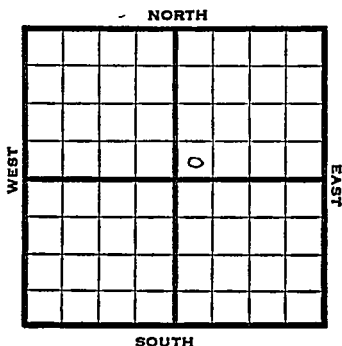

1951	Elev. 2249'	REPORT
11/21	Spud 11-18-51 8" @ 155 Dr1g. 1470'	
1952 1/16	Spud 11-18-51 Oil Well TD 3856' 8" @ 155' Anhy 1728 Heeb. 3485 Tor. 3510 Lans. 3525 DST 3602-17 open 15 min. rec. 1020' SW Cong. 3830 Arb. 3851-56 5" @ 3851 TD 3856 FU 75' oil 3 hr. B/ 15 GOPH 4 hr. 500 A S/ 25 BOPH 5 hr. Comp. 381 BOPD	
COMPLETED		

J. E. TYRA


County Rooks State Kansas

Sec. 7 (Blk. Twp.) 10 (Sur. Rge.) 20^W Map No.

Operator Brooks Hall

Well No. 2 Farm Sauer

Elev. 2249 Location SW SW NE

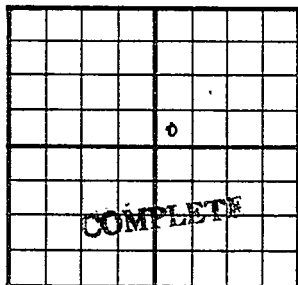

330 Ft. From S Line NE

330 Ft. From W Line Quarter

1st. Report

Completion JAN 16 1952

Remarks Palco Pool

J-S-F' - Contr.

Spudding Date 11-18-51

Drlg. Data Oil well TD 3856

8" @ 155 Anhy 1728 Heeb. 3485

Tor. 3510 Lans. 3525 DST 3602-17

open 15 min. Rec. 1020' sw Cong. 3830

Arb. 3851-56 5" @ 3851 TD 3856

FU 75' oil 3 hr. B/ 15 goph 4 hr.

500 A S/ 25 boph 5 hr.

Comp. 381 bopd

J. E. TYRA